

FROM THE OFFICE OF

CHARLES O. GEORGI COMPANY

2215 West County Road B

Saint Paul, Minnesota 55113

REGISTERED CIVIL ENGINEER AND LAND SURVEYOR



I Heroby Certify that this plat shows a survey made by me of the property described on this plat, and that the corners are correctly placed as shown, and that all locations have been correctly shown.

Surveyed For Bob Walker

Date March 1977


Scale 1" = 40'

By *Charles O. Georgi*
REGISTERED LAND SURVEYOR

Description:

Lots 27, 28, 29 and the North 1/2 of adjoining vacated Alley, Windsor Square, Ramsey County, Minnesota.

66 MAGNOLIA AVE. 66

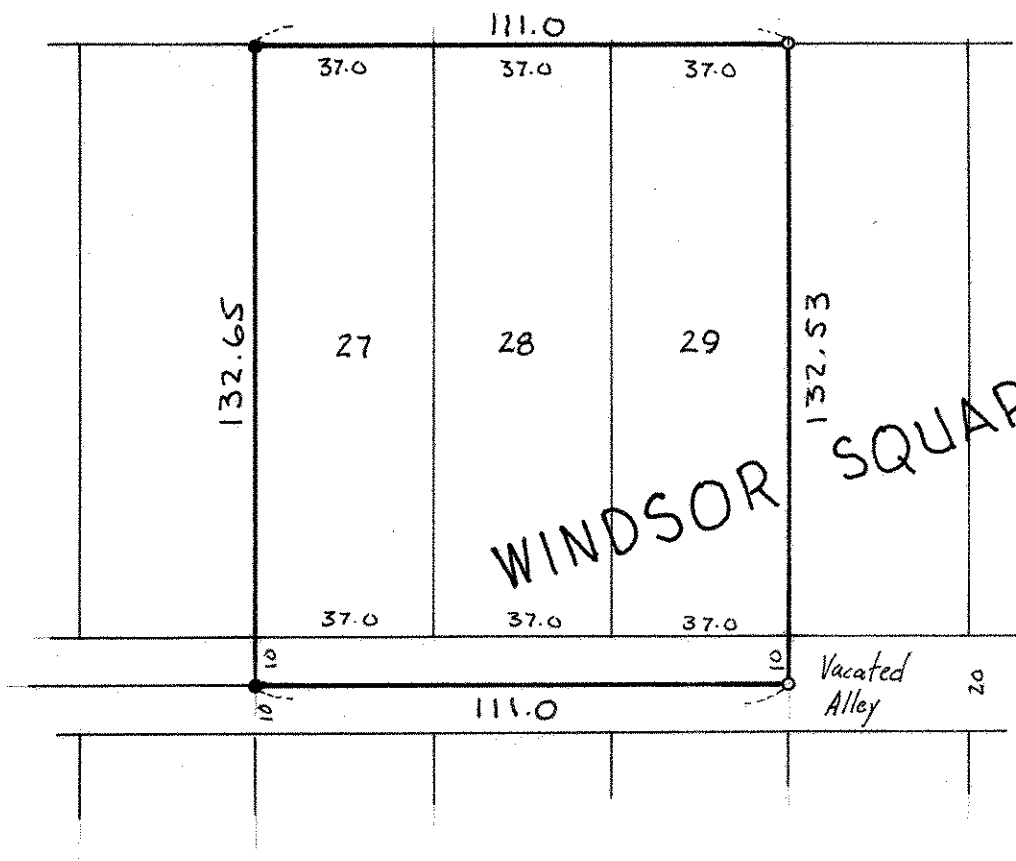

o denotes iron pipe monument
● denotes iron pipe monument found in place