

FROM THE OFFICE OF

# CHARLES O. GEORGI COMPANY

2215 West County Road B

Saint Paul 13, Minnesota

REGISTERED CIVIL ENGINEER AND LAND SURVEYOR

## Certificate of Survey

I Hereby Certify that this plat shows a survey made by me of the property described on this plat, and that the corners are correctly placed as shown, and that all locations have been correctly shown.

Surveyed For MR. C. HENDRICKS

Date October 1959


Scale 1" = 50'

By Charles O. Georgi  
REGISTERED LAND SURVEYOR

Description:

The East 60 feet of  
Lot 5  
Block 12  
FURNESS' GARDEN LOTS

### E. NEBRASKA AVE.

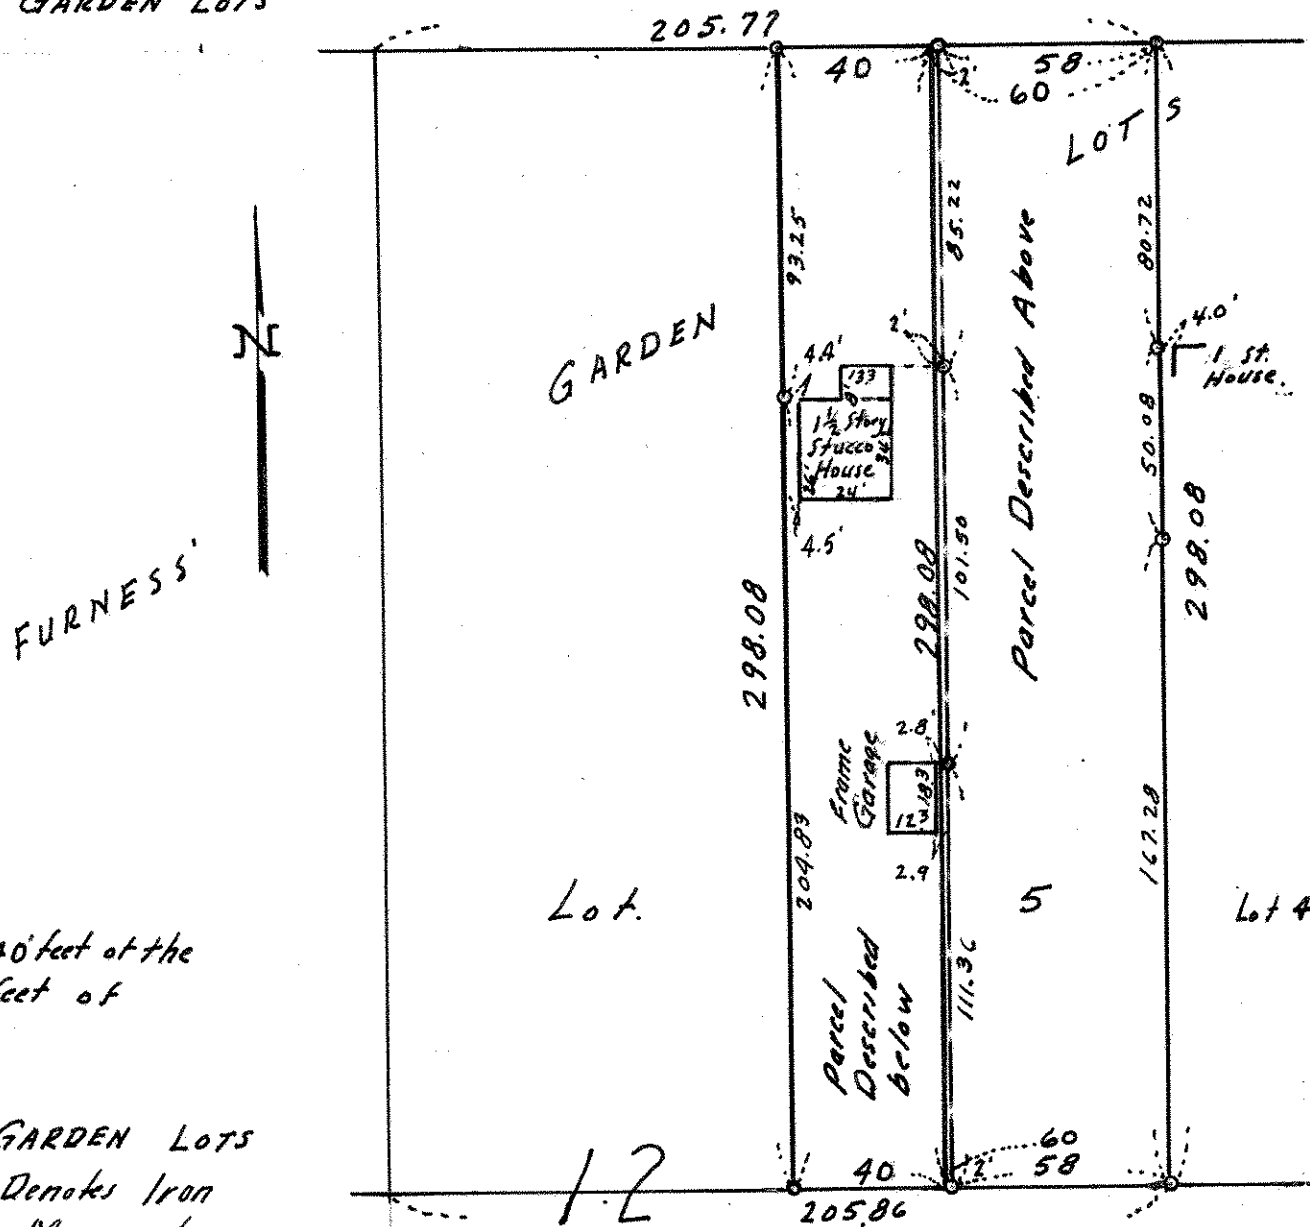

Description:

The West 40 feet of the  
East 100 feet of  
Lot 5  
Block 12  
FURNESS' GARDEN LOTS

o Denotes Iron  
Monument.