NE 31 29 22

Certificate of Survey

From the office of

GEORGI- SCHMIDT & ASSOC. INC.

3092 No. Lexington Ave., Roseville, Mn. 55113

LAND SURVEYING

483-4408

I Hereby Certify that this plat shows a survey made by me of the property described on this plat, and that the corners are correctly placed as shown, and that all locations have been correctly shown.

Job Number: 1078

Surveyed For Gordon Hedlund

Date 10/5/81

Scale 1" = 30'

By Donald W. Schmidt

REGISTERED LAND SURVEYOR

Description:
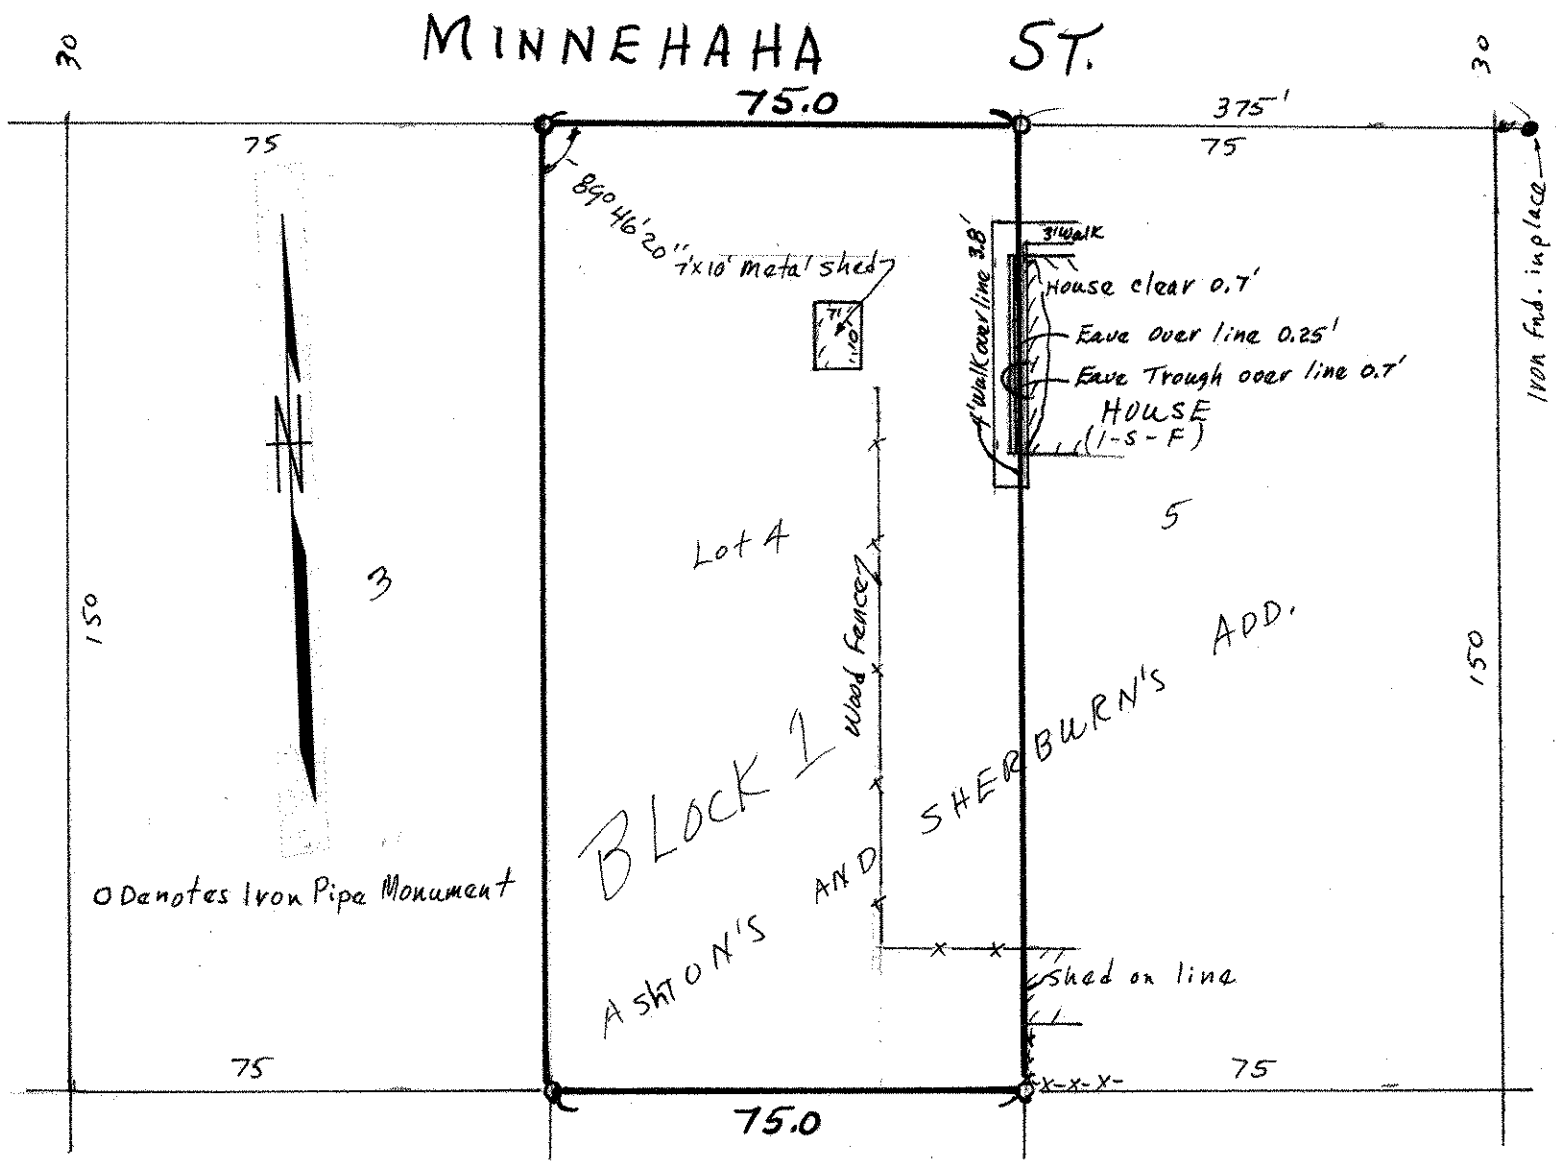
Lot 4, Block 1, Ashton's and Sherburn's Add.
Ramsay County, MN.