

FROM THE OFFICE OF

CHARLES O. GEORGI COMPANY

2215 West County Road B

Saint Paul, Minnesota 55113

REGISTERED CIVIL ENGINEER AND LAND SURVEYOR



I Hereby Certify that this plat shows a survey made by me of the property described on this plat, and that the corners are correctly placed as shown, and that all locations have been correctly shown.

Surveyed For Del Arrigoni


Date July 1970

Scale 1"=30'

By Charles O. Georgi
REGISTERED LAND SURVEYOR

Description:

The East 170.7 feet of Lot 7, Block 6, Rogers and Hendricks Acre Lots No. 2 except the South 50.9 feet thereof, and except the South 55.9 feet of the East 135.7 feet thereof, St Paul, Ramsey County, Minn

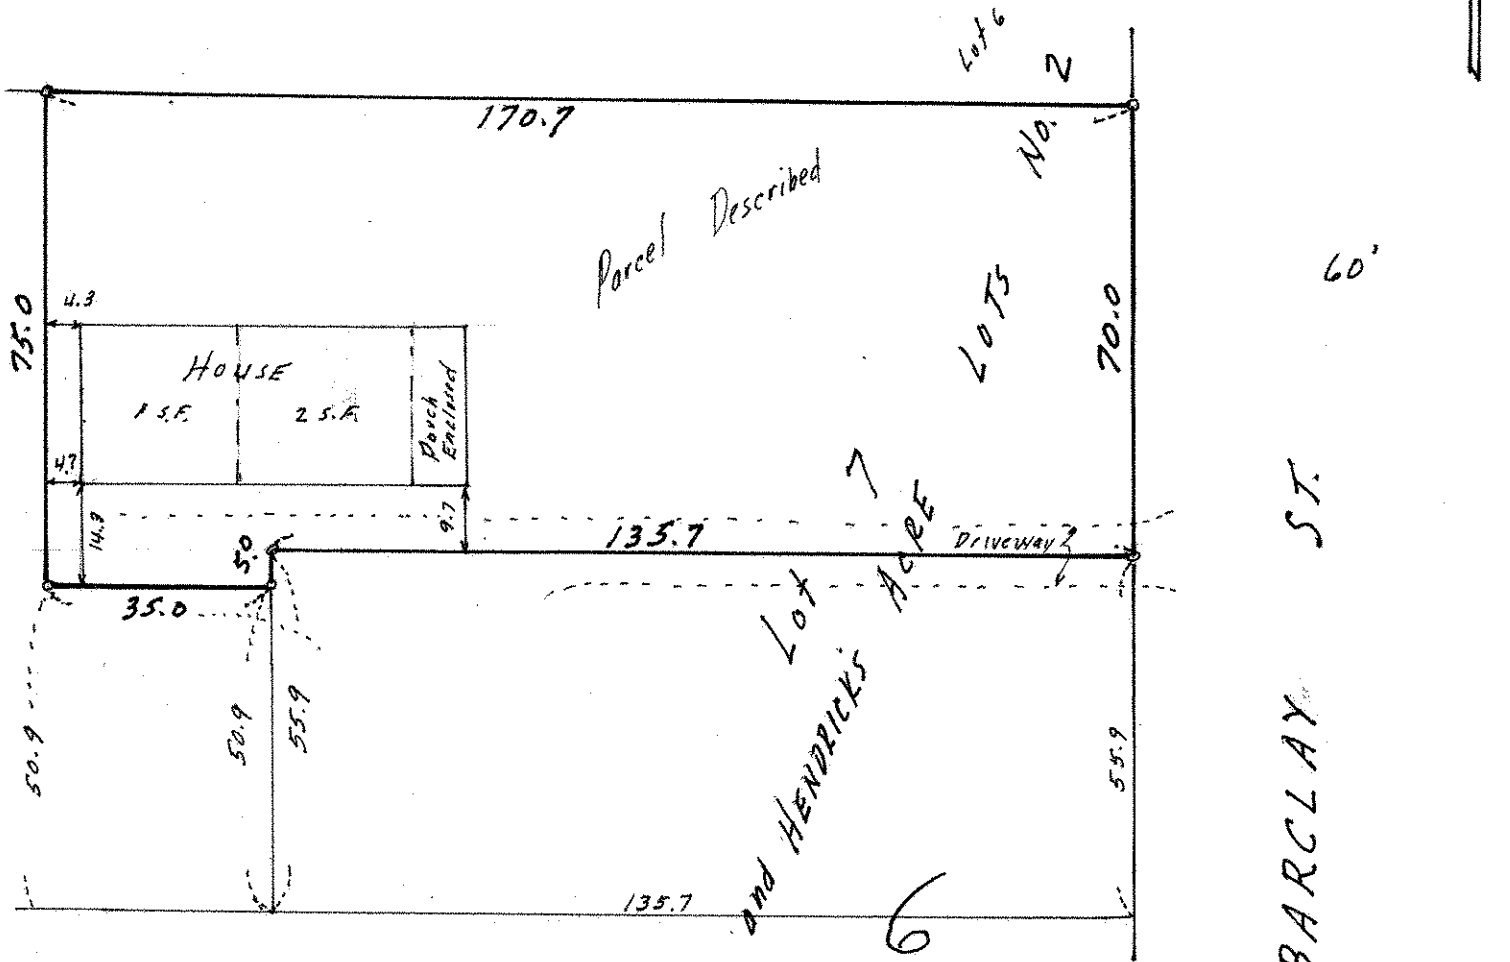

o Denotes Iron Monuments
Lot measurements are prorated.

Lot 6
ROGERS and HENDRICKS ACRE
Lot 7

BARCLAY ST.