

SE 12 29 23
22

FROM THE OFFICE OF

CHARLES O. GEORGI COMPANY

2215 West County Road B

Saint Paul, Minnesota 55113

REGISTERED CIVIL ENGINEER AND LAND SURVEYOR



Certificate of Survey

I Hereby Certify that this plat shows a survey made by me of the property described on this plat, and that the corners are correctly placed as shown, and that all locations have been correctly shown.

Surveyed For ^{File} August Const. (owner: John Branschar)

Date April 1976

Scale 1" = 40'


By *Charles O. Georgi*
REGISTERED LAND SURVEYOR

Description:

Lot 1, and the West 33.0 feet of Lot 2,
Block 24, 2nd Addition to North St. Paul.

Ramsay County, Minnesota

60 FIRST AVE. 60

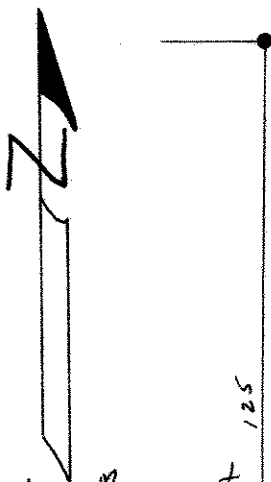

- Denotes Iron Monument
- Denotes Iron Found in place
- (R) Denotes record plat distance
- (m) Denotes measured distance

