

Certificate of Survey

From the office of
GEORGI-SCHMIDT & ASSOC. INC.
3092 No. Lexington Ave., Roseville, Mn. 55113
LAND SURVEYING
483-4408

I Hereby Certify that this plat shows a survey made by me of the property described on this plat, and that the corners are correctly placed as shown, and that all locations have been correctly shown.

Job Number: 901

Surveyed For Ruth Ryan

Date 11/12/80


Scale 1" = 30'

By Donald W. Schmidt
REGISTERED LAND SURVEYOR

Description:

lot 4, Block 3, Lake Gervais Peninsula

Ramsey County, Mn.

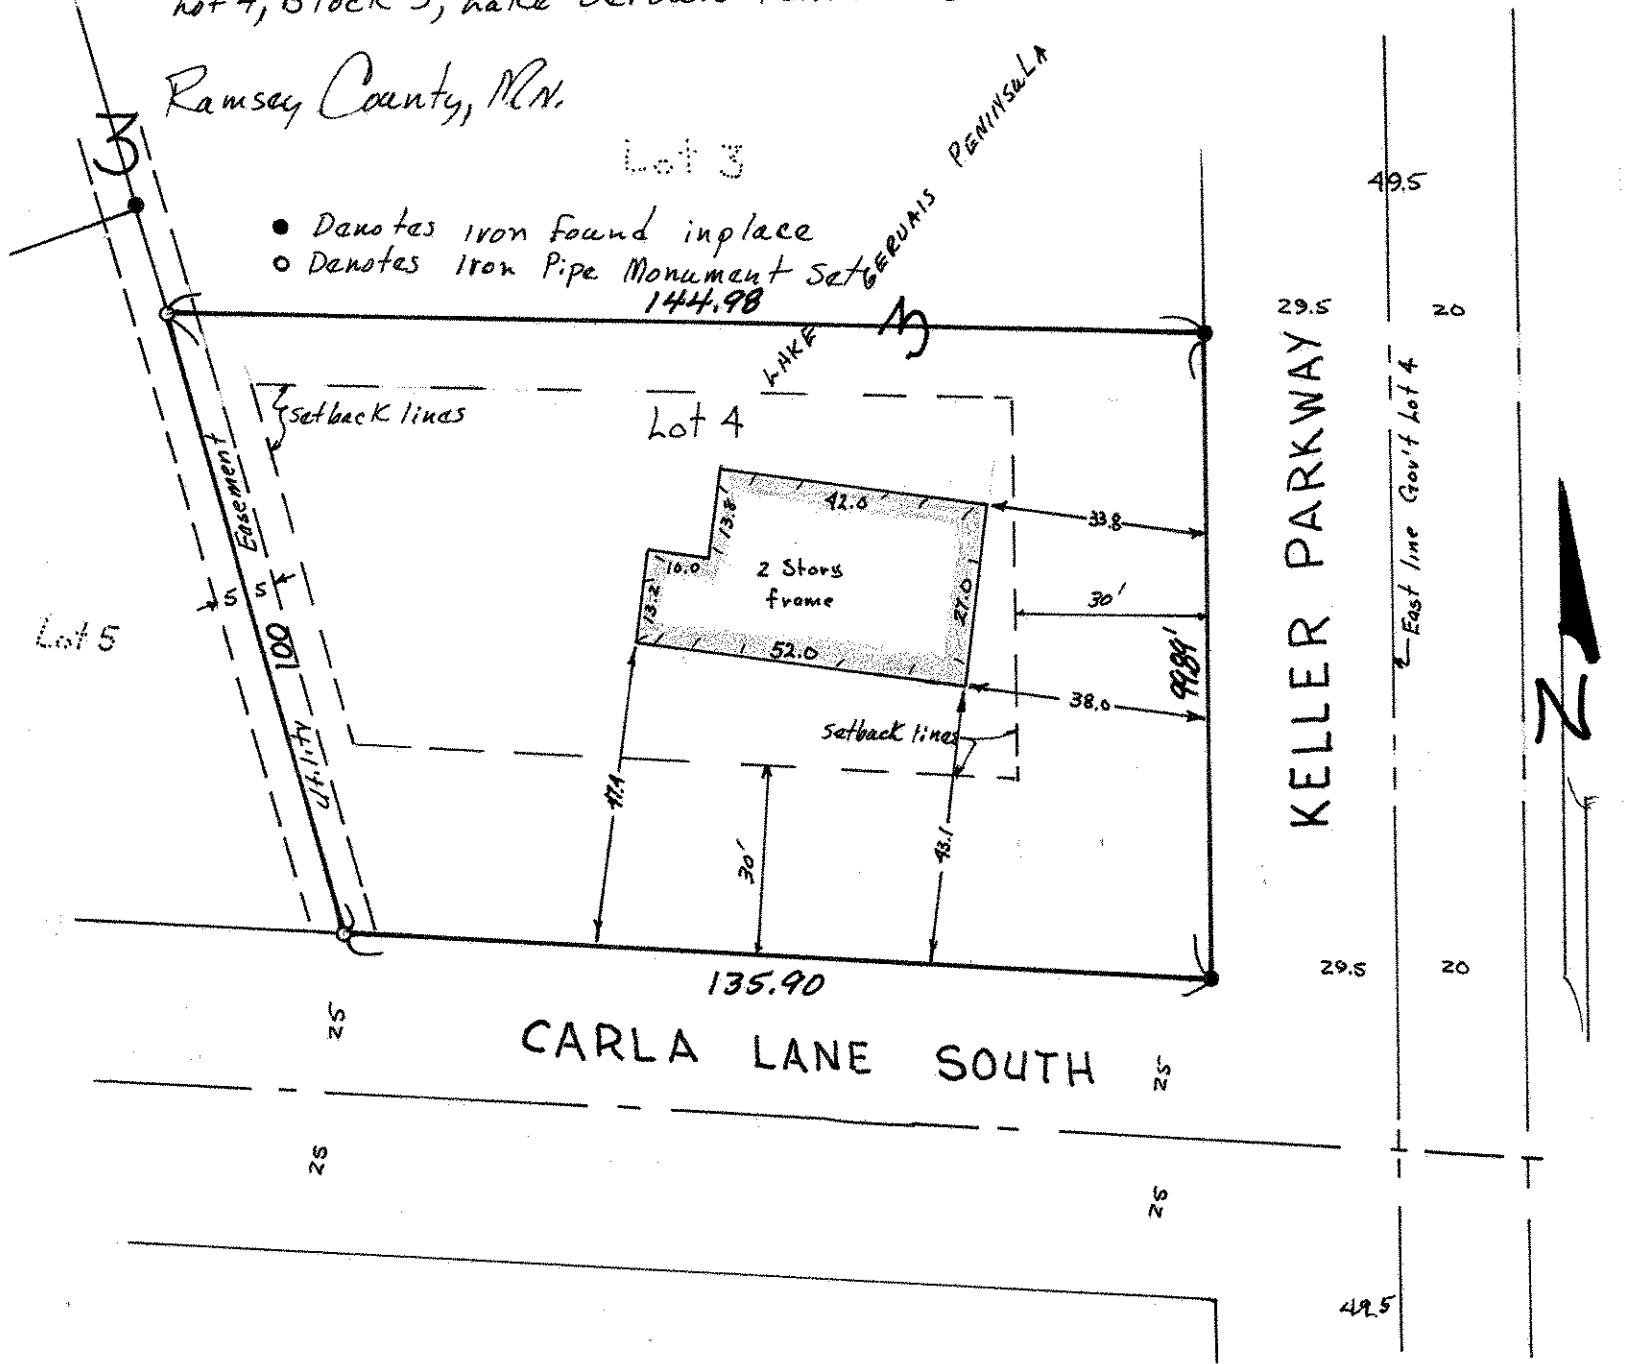

- Denotes Iron Found in place
- Denotes Iron Pipe Monument Set

Lot 3

Lot 4

Lot 5

CARLA LANE SOUTH

KELLER PARKWAY

Lake Gervais Peninsula

setback lines

setback lines

Easement

135.90

49.5

29.5

20

29.5

20

49.5

25

25

25

25

