NW 6 29 22

Certificate of Survey

From the office of

GEORGI- SCHMIDT & ASSOC. INC.

3092 No. Lexington Ave., Roseville, Mn. 55113
LAND SURVEYING
483-4408

I Hereby Certify that this plat shows a survey made by me of the property described on this plat, and that the corners are correctly placed as shown. ~~and that all locations have been correctly shown~~.

Job Number: 1658

Surveyed For Art Ryan

Date 8/30/84

Scale 1" = 100'

By _____
REGISTERED LAND SURVEYOR

Description: (Contains 57,738.78 sq. ft., more or less)

The Northerly 140.0 feet, as measured at right angles to the Northerly line, of Lot 6, Block 2, Ryan Industrial Park. Subject to easements of record.
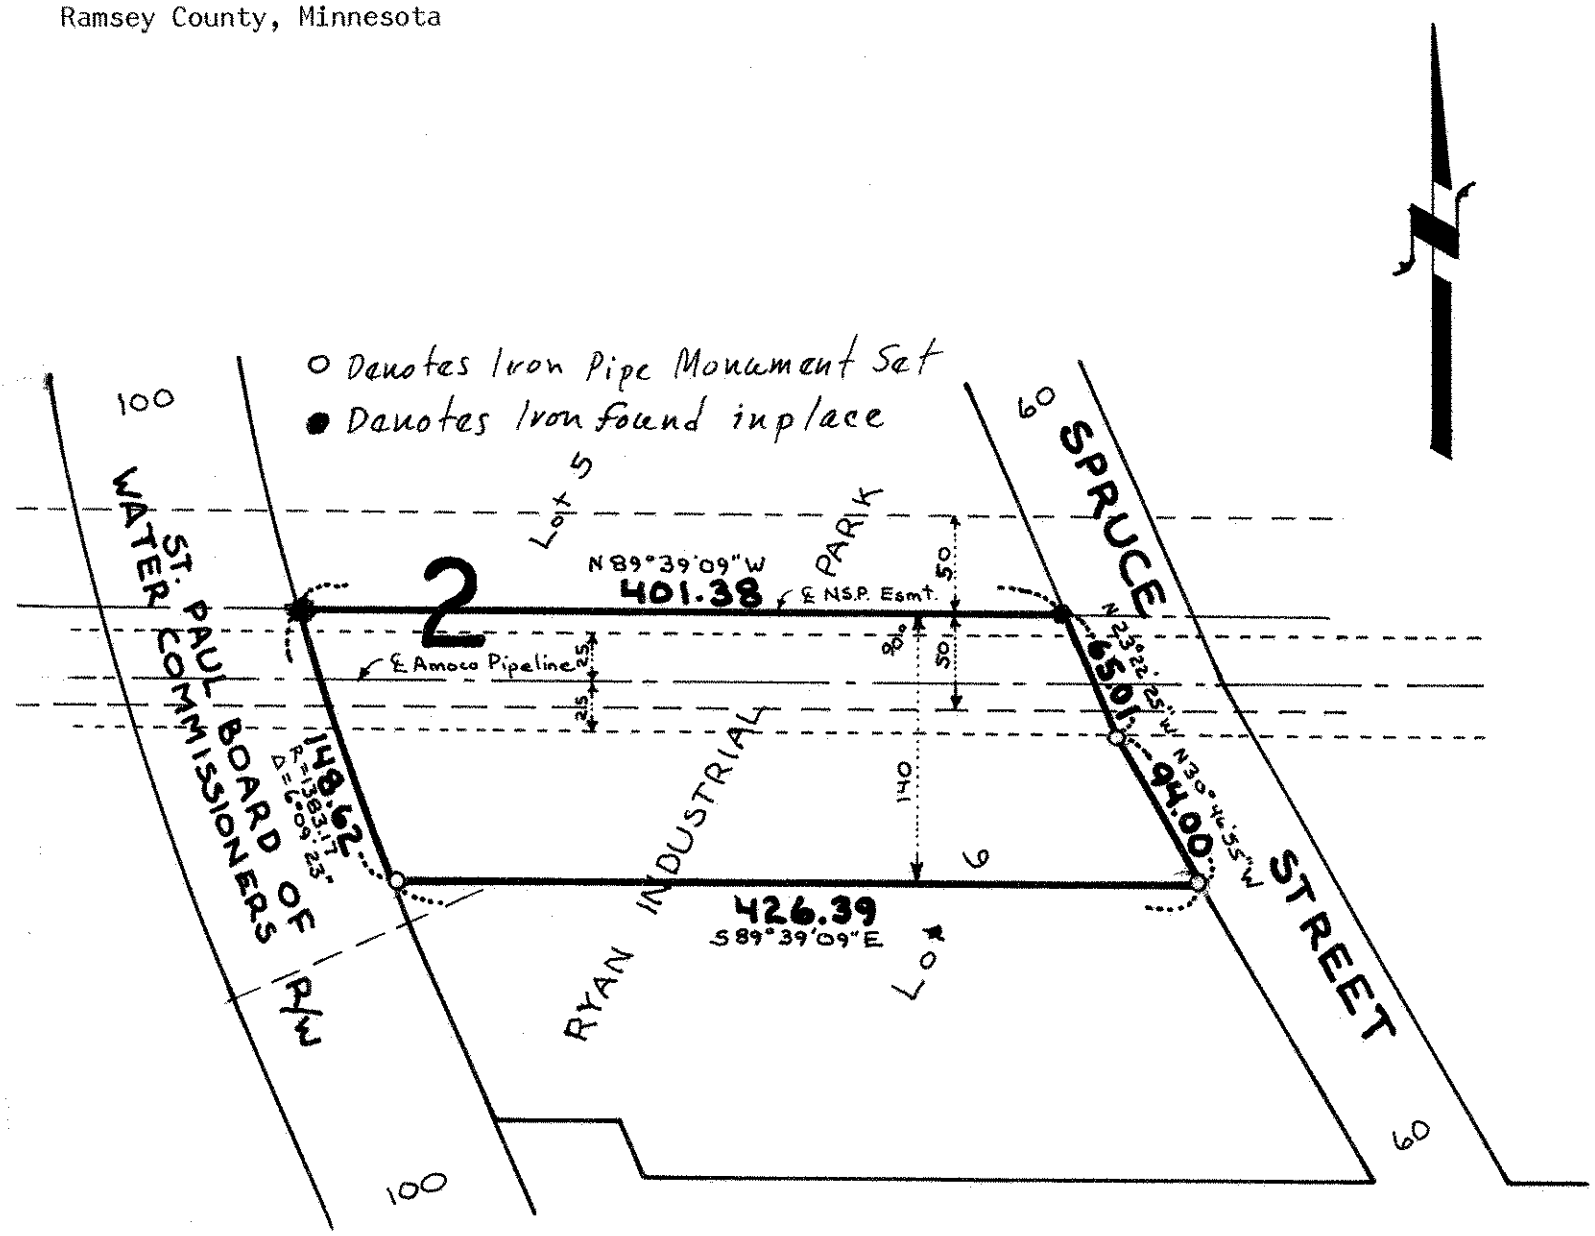
Ramsey County, Minnesota