FROM THE OFFICE OF

## Certificate of Survey

## **CHARLES O. GEORGI COMPANY**

2215 West County Road B

Saint Paul, Minnesota 55113

REGISTERED CIVIL ENGINEER AND LAND SURVEYOR

I Hereby Certify that this plat shows a survey made by me of the property described on this plat, and that the corners are correctly placed as shown, and that all locations have been correctly shown.

Surveyed For John Walsh + Michels Const


Date December 1974

Scale "- 40"

By RECISTERED LAND SURVEYOR

Description:

Lot 18, Block 20, Oak Ville Park Ramsey County. Minnesota

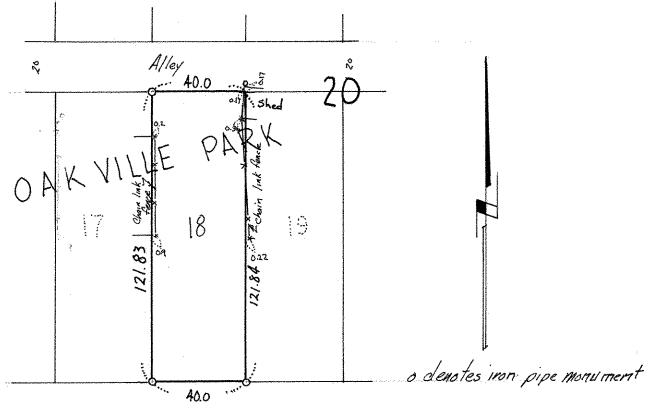

JESSAMINE AVE.

-2