Certificate of Survey

From the office of NE 1 29 22

GEORGI- SCHMIDT & ASSOC. INC.

3092 No. Lexington Ave., Roseville, Mn. 55113
LAND SURVEYING
483-4408

I Hereby Certify that this plat shows a survey made by me of the property described on this plat, and that the corners are correctly placed as shown, that this survey, plan or report was prepared by me, or under my direct supervision; and that I am a duly registered Land Surveyor under the Laws of the State of Minnesota.

Job Number: 3169

Surveyed For Ernie Reinhardt

Date October 27, 1986

Scale 1"=60'

By _____
REGISTERED LAND SURVEYOR
Mn. Registration No. 10459

DESCRIPTION: (Total-as furnished)

That part of Lot B, Rearrangement of Blocks 1,2,3,4,5,6,9, A and B, Lake Side Park Addition to North St. Paul described as beginning at the Southwest corner of said Lot B; thence Northerly 200 feet along the West line of said Lot B; thence at right angles 230 feet to a point; thence at right angles to the South line of said Lot B; thence to the point of beginning. Subject to 10 foot sewer easement along Southerly 10,0 feet thereof.
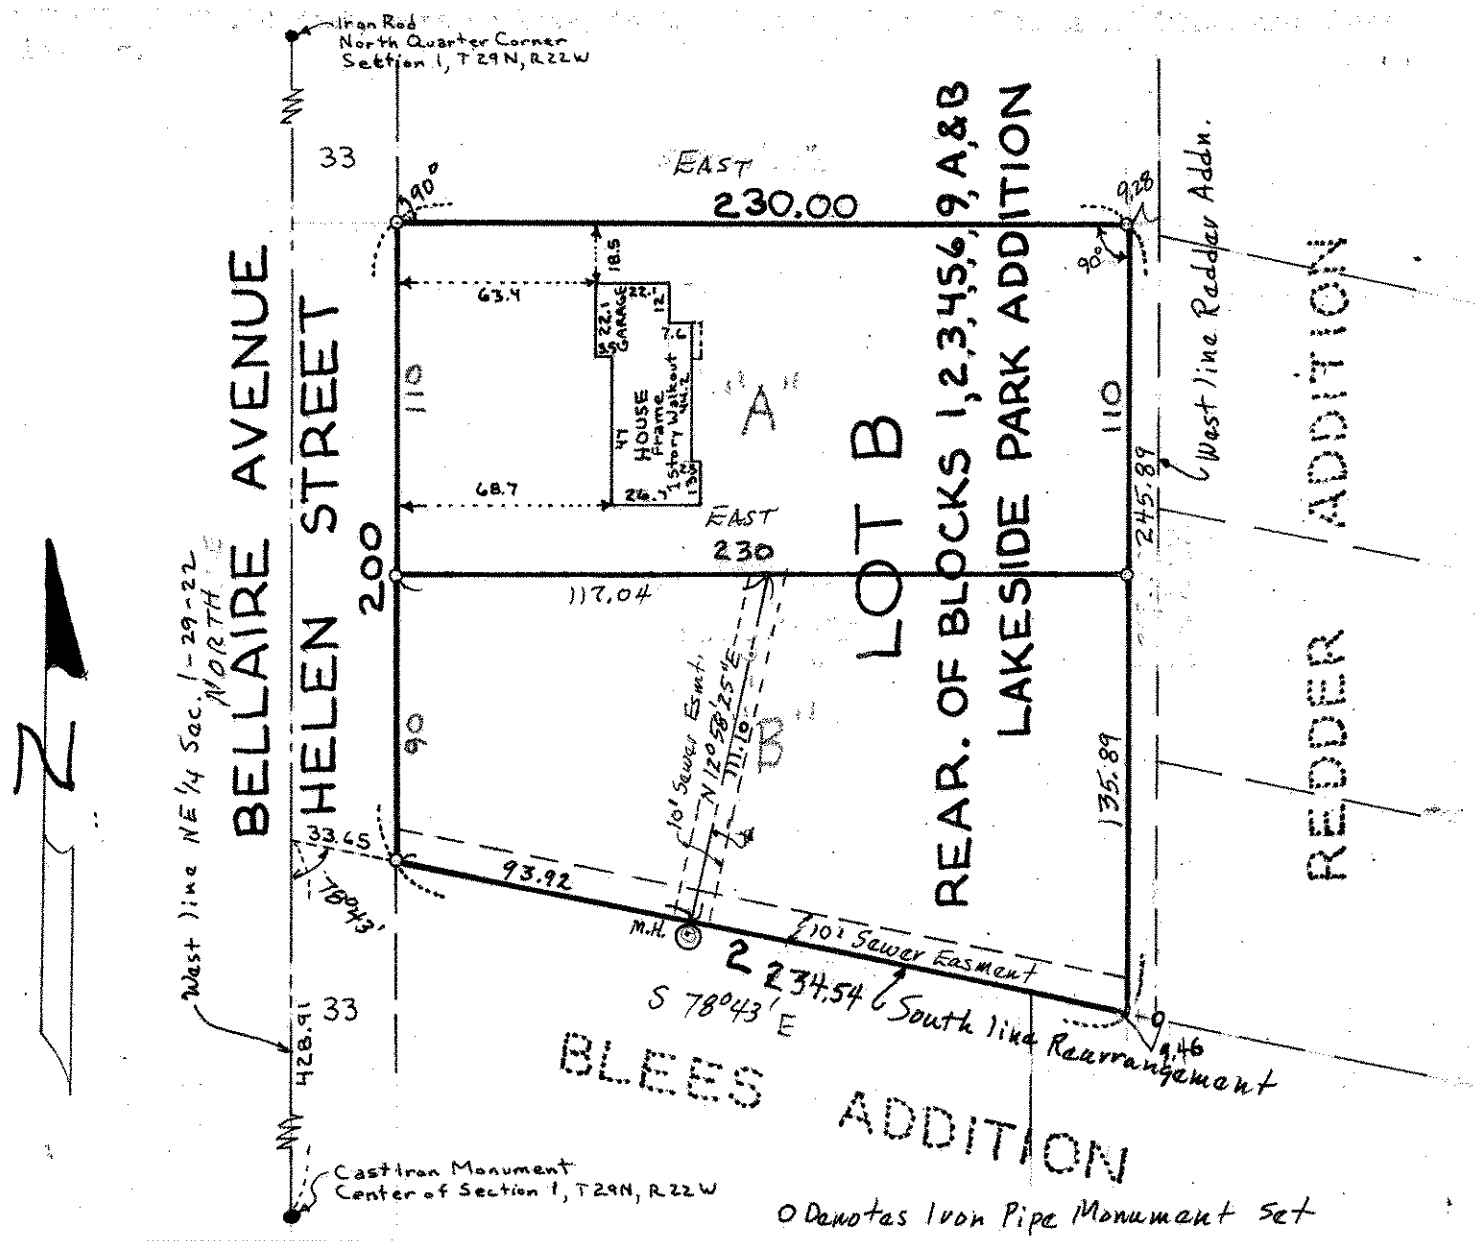
Ramsey County, Minnesota