NE 20 29 22

FROM THE OFFICE OF

# CHARLES O. GEORGI COMPANY

2215 West County Road B Saint Paul, Minnesota 55113

REGISTERED CIVIL ENGINEER AND LAND SURVEYOR

# Certificate of Survey

***I Hereby Certify that*** **this plat shows a survey made by me of the property described on this plat, and that the corners are correctly placed as shown, and that all locations have been correctly shown.** 5/24/76 Revised Easterly parcel to 20' and added description

***Surveyed For*** Raymond Resch

***Date*** May 1976

***Scale*** 1" = 50'

By Charles O. Georgi
REGISTERED LAND SURVEYOR

***Description:***
Total parcel:
The South 1/2 of Lots 13, 14, and 15, Block 13, Harrison and Hardy's Addition to the City of St. Paul.
Ramsay County, Minn.
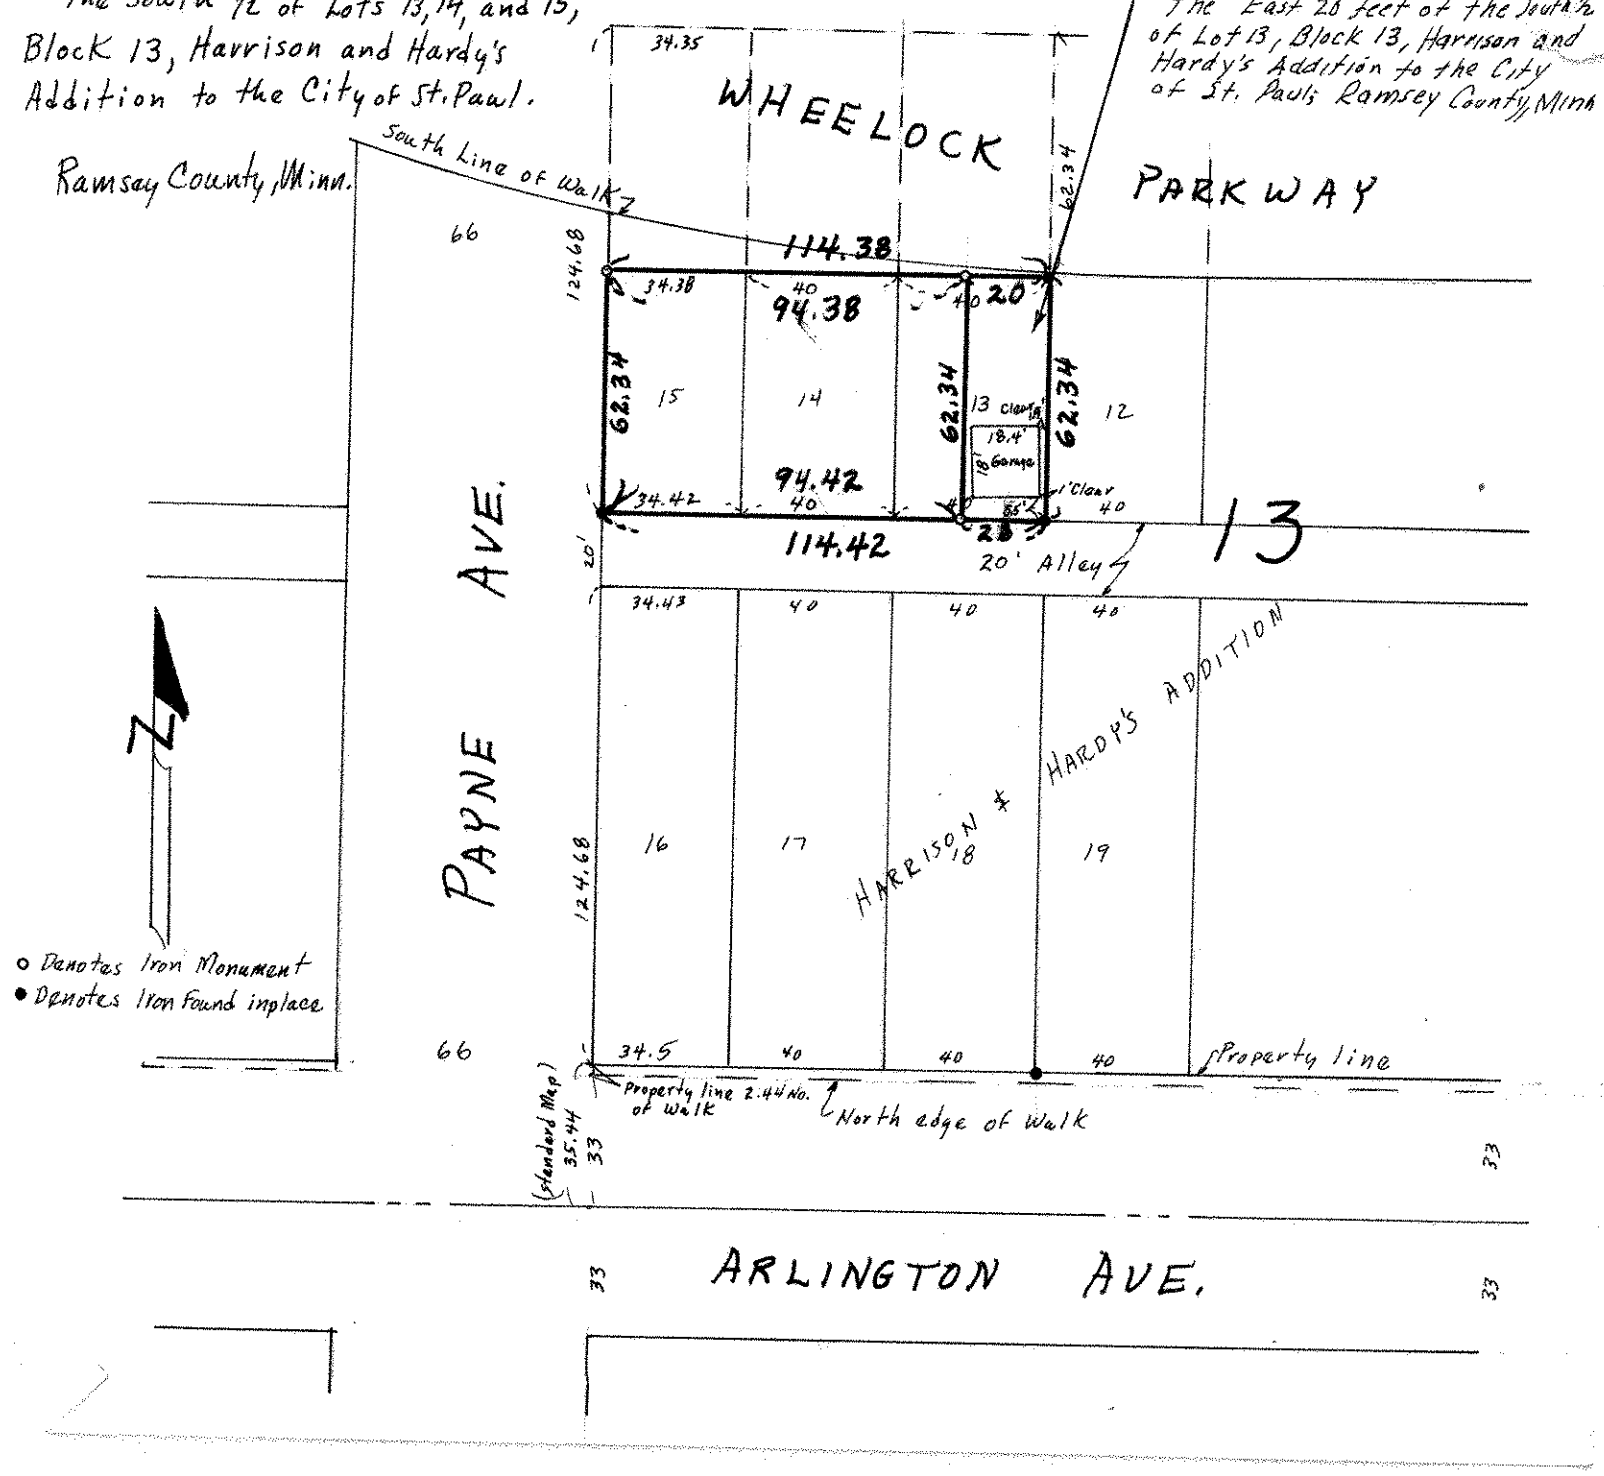
Description
The East 20 feet of the South 1/2 of Lot 13, Block 13, Harrison and Hardy's Addition to the City of St. Paul; Ramsey County, Minn