SW 10 29 22

FROM THE OFFICE OF

CHARLES O. GEORGI COMPANY

2215 West County Road B Saint Paul, Minnesota 55113

REGISTERED CIVIL ENGINEER AND LAND SURVEYOR

Certificate of Survey

I Hereby Certify that **this plat shows a survey made by me of the property described on this plat, and that the corners are correctly placed as shown, and that all locations have been correctly shown.**

Surveyed For Raymond Robertson

Date June 1976

Scale 1" = 40'

By Charles O. Georgi
REGISTERED LAND SURVEYOR

Description:

Lots 1 and 2, Block 7, Sabin's Addition to Gladstone, and the North ½ of adjoining vacated alley.

Ramsey County, Minnesota
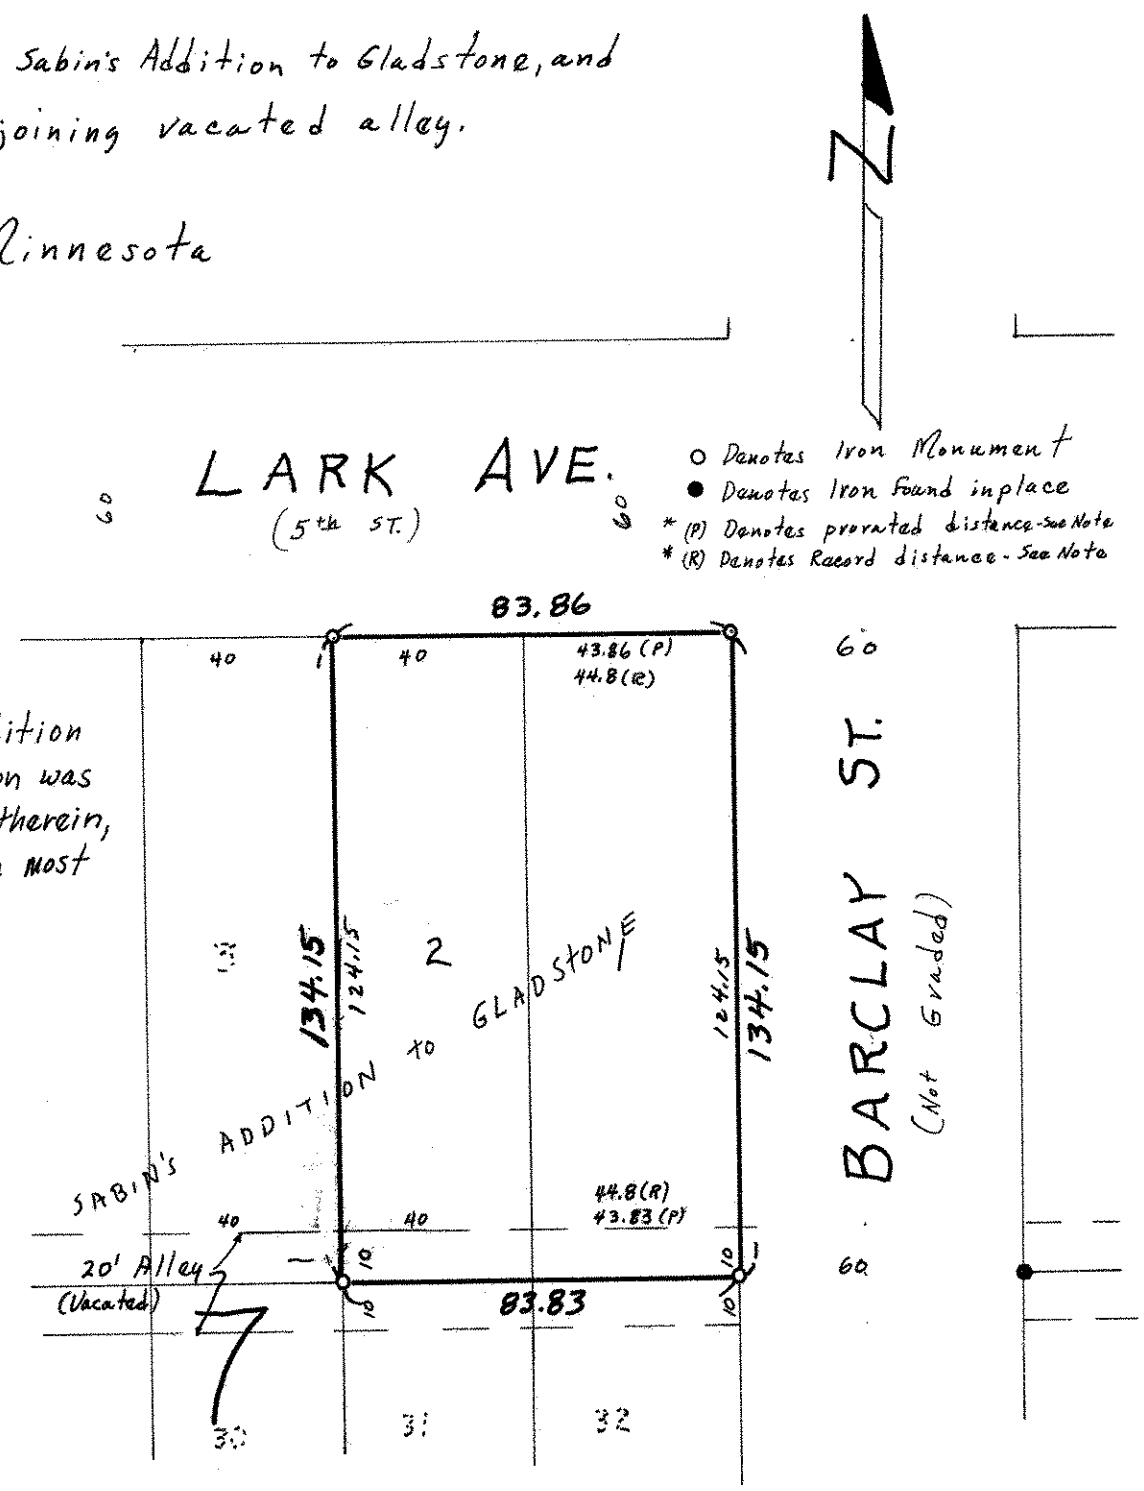
Surveyor's Note:
The plat of Sabin's Addition within the Quarter Section was measured and prorated therein, and is in agreement with most irons inplace.