

FROM THE OFFICE OF

CHARLES O. GEORGI COMPANY

2215 West County Road B

Saint Paul 13, Minnesota

REGISTERED CIVIL ENGINEER AND LAND SURVEYOR



I Hereby Certify that this plat shows a survey made by me of the property described on this plat, and that the corners are correctly placed as shown, and that all locations have been correctly shown.

Surveyed For NEUJAHN CONST. Co.


Date Sept. 1961

Scale 1" = 50'

Description:

Lot 12
Block 5
Chelsea Heights

By Charles O. Georgi
REGISTERED LAND SURVEYOR

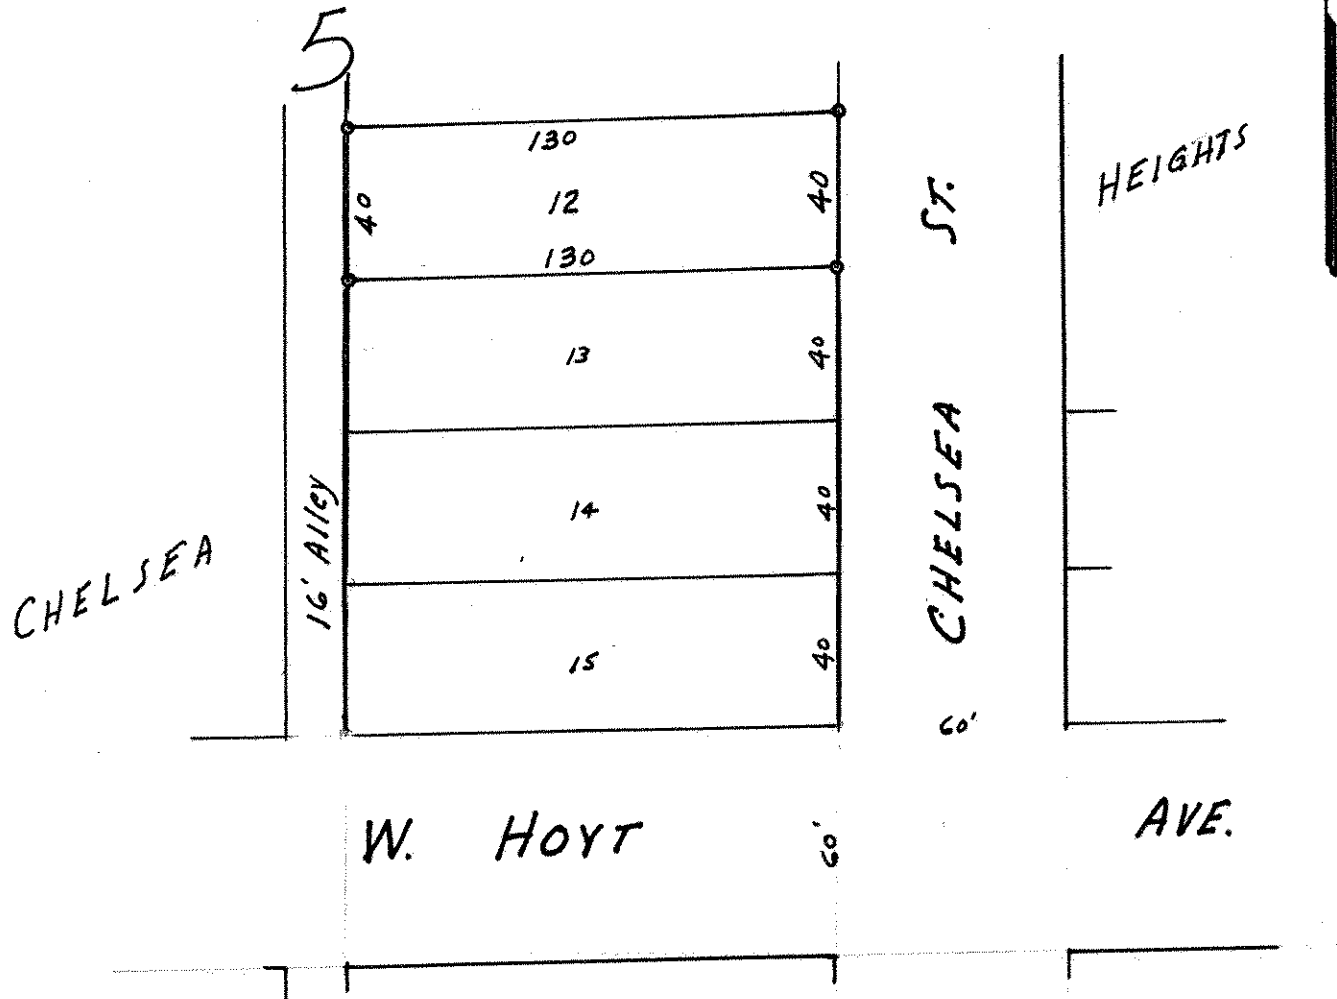

• Denotes Iron Monument