SHEET METAL SE¼ 10 29 22

Date _____ Sheet No _____

For _____

By _____

TRAVERSE CLOSURE
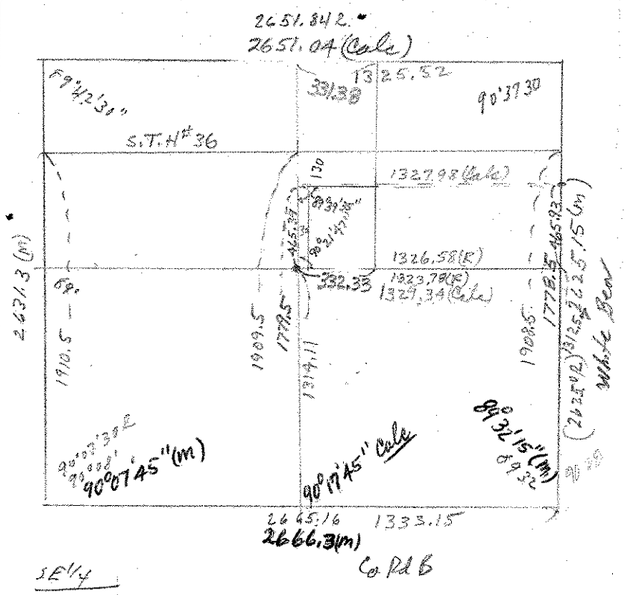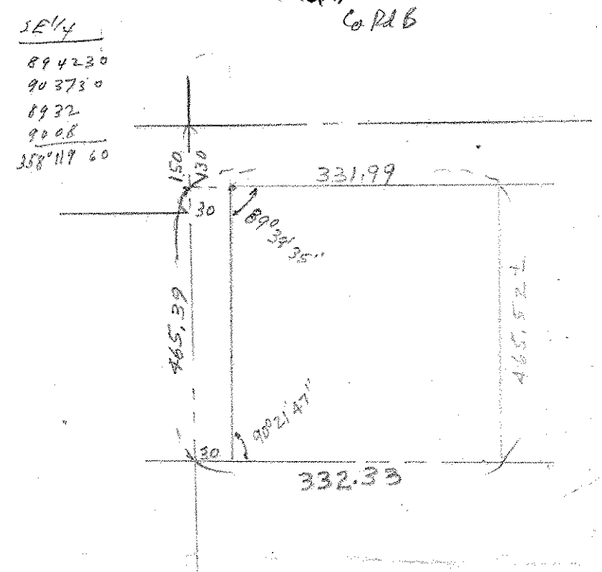
Station or line	Distance	Deflection Lt.	Deflection Rt.	Bearing of Course	Latitude North(+)	Latitude South(-)	Departure East (+)	Departure West (-)
SE¼	10 29	22						
Record info	2625.15			South	X	2625.15	X	X
	2666.4	.00814478	.99996683	N 89°32' W	21.72	X	X	2666.31
	2631.3	.99998308	.00581773	N 0° 20' E	2631.26	X	15.31	X
	2651.84	.01090809	.99994051	S 89°22'30"	X	28.92	2651.68	X
					2652.98	2654.07	2666.99	2666.31
					1.09			0.68
Field Info - SE¼ 10-29-22								
	2625.15			South	X	2625.15	X	X
	2666.3	.00807206	.99996142	N 89°32'15" W	21.52	X	X	2666.21
	2631.3	.99998308	.00581773	N 0° 20' E	2631.26	X	15.31	X
Find →	2651.04	.01042331	.99994568	S 89°24'10" E	X	27.63	2650.90	
					2652.78	2652.78	2666.21	2666.21
SE¼ of SE¼								
	1312.57			South	X	1312.57	X	X
	1333.15			N 89°32'15" W	10.76	X	X	1333.10
	1314.11	.99999577	.00290888	N 0° 10' E	1314.10	X	3.82	X
	1329.34	.00924527	.99995726	S 89°28'13" E	X	12.29	1329.28	X
NE¼ of SE¼ -	130' So E #36							
	465.93			South	X	465.93	X	X
	1329.34			N 89°28'13" W	12.29	X	X	1329.28
	465.39	.99999577	.00290888	N 0° 10' E	465.39	X	1.35	X
	1327.98	.00884773	.99996086	S 89°29'35" E	X	11.75	1327.93	X
Parcel - Prorated	Lot 13, E.G. Rogers, but Brunson use 331.0 only - 30' street							
	332.33	.00924527	.99995726	N 89°28'13" W	3.07	X	X	332.32
	465.39	.99999577	.00290888	N 0° 10' E	465.39	X	1.35	X
	331.99	.00884773	.99996086	S 89°29'35" E	X	2.94	331.98	X
	465.52	.00216712	.99999765	S 89°52'33" W	X	465.52	X	1.01