NW 14 30 22

Certificate of Survey

From the office of

GEORGI- SCHMIDT & ASSOC. INC.

3092 No. Lexington Ave., Roseville, Mn. 55113
LAND SURVEYING
483-4408

I Hereby Certify that this plat shows a survey made by me of the property described on this plat, and that the corners are correctly placed as shown, and that all locations have been correctly shown.

Job Number: 539

Surveyed For ALVIN Le MIRE

Date NOV 1979

Scale 1" = 40'

By Donald W. Schmidt
REGISTERED LAND SURVEYOR

Description:
Lot 14 & East 15' of Lot 15
Block 2
BRONSON'S Addition
RAMSEY County, MINN.

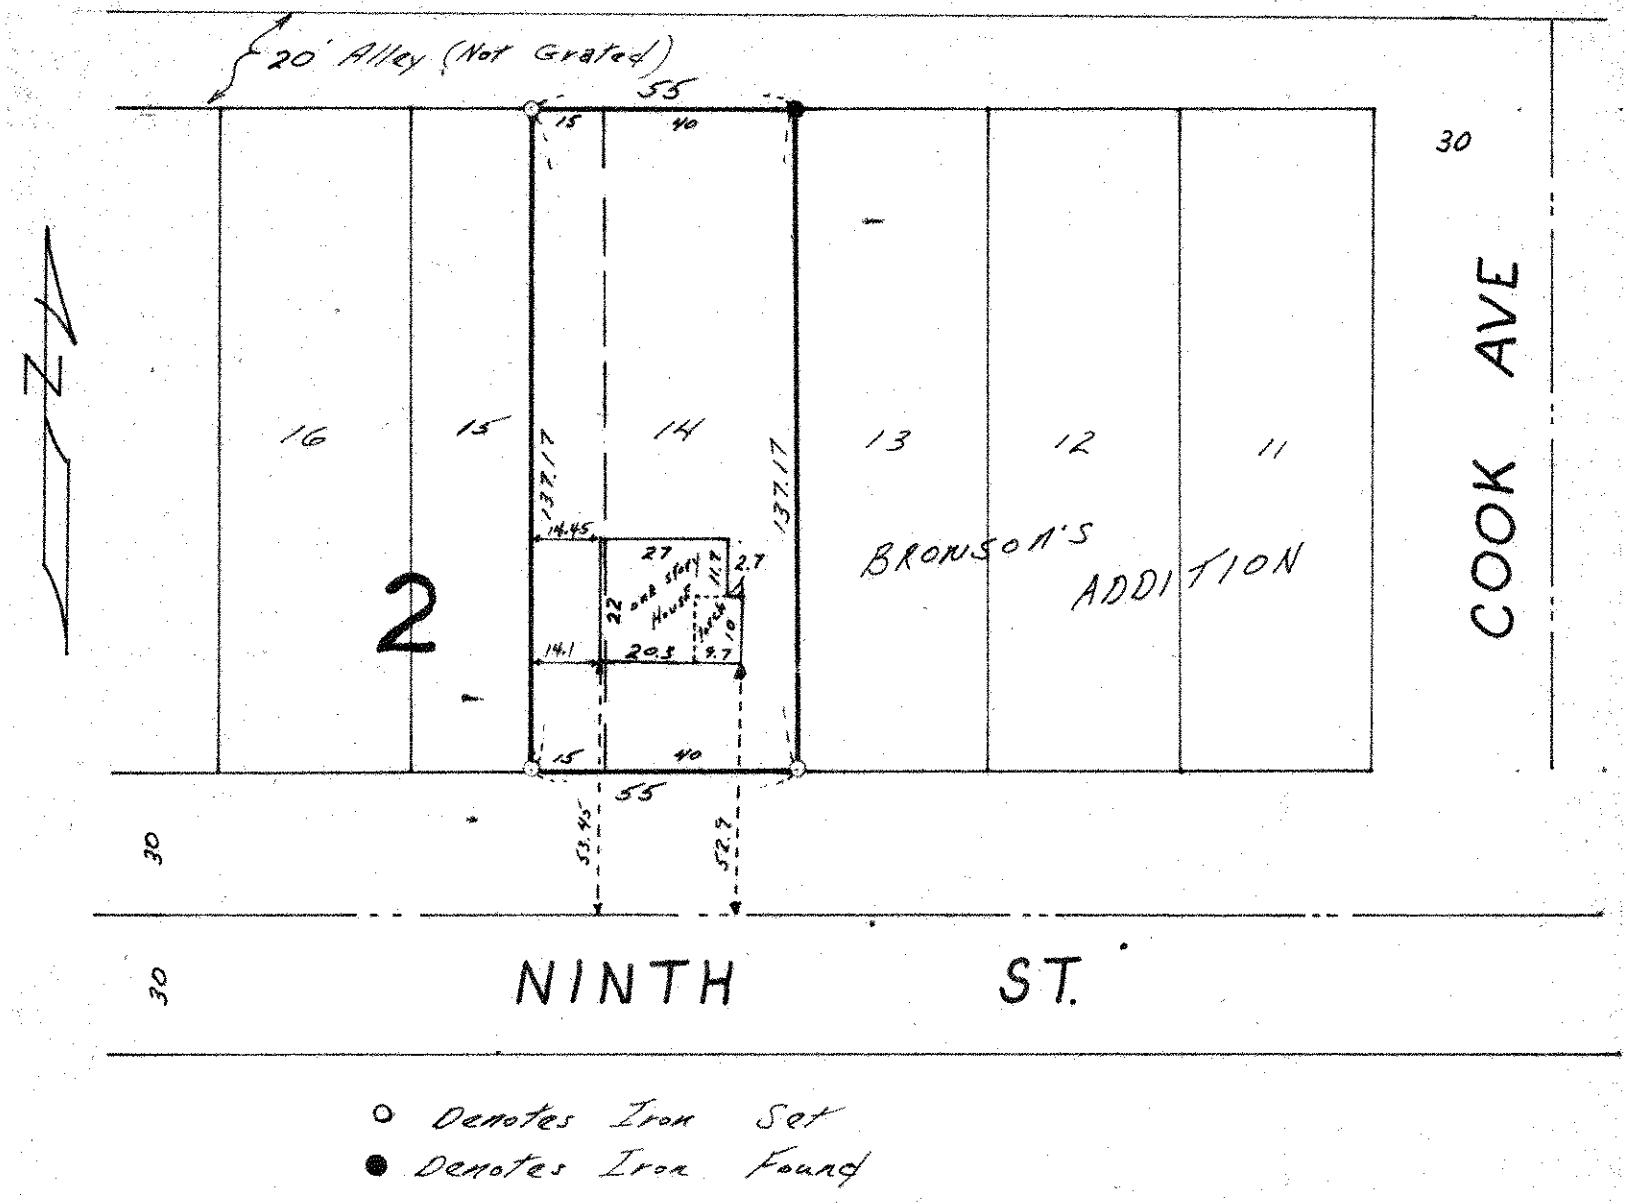

○ Denotes Iron Set
● Denotes Iron Found