


# PLAT OF SURVEY

OF PROPERTY OF \_\_\_\_\_

DESCRIBED AS FOLLOWS Lots 11 and 12, except So. 105 ft. Block 3,  
Brunson Add. to Town of St. Paul.  
No. 577 Brunson St. Paul, Minn.

SCALE: 1 INCH. 30 FEET.

T. J. WELCH, REGISTERED SURVEYOR  
 738 VAN BUREN PLACE, ST. PAUL, MINN.

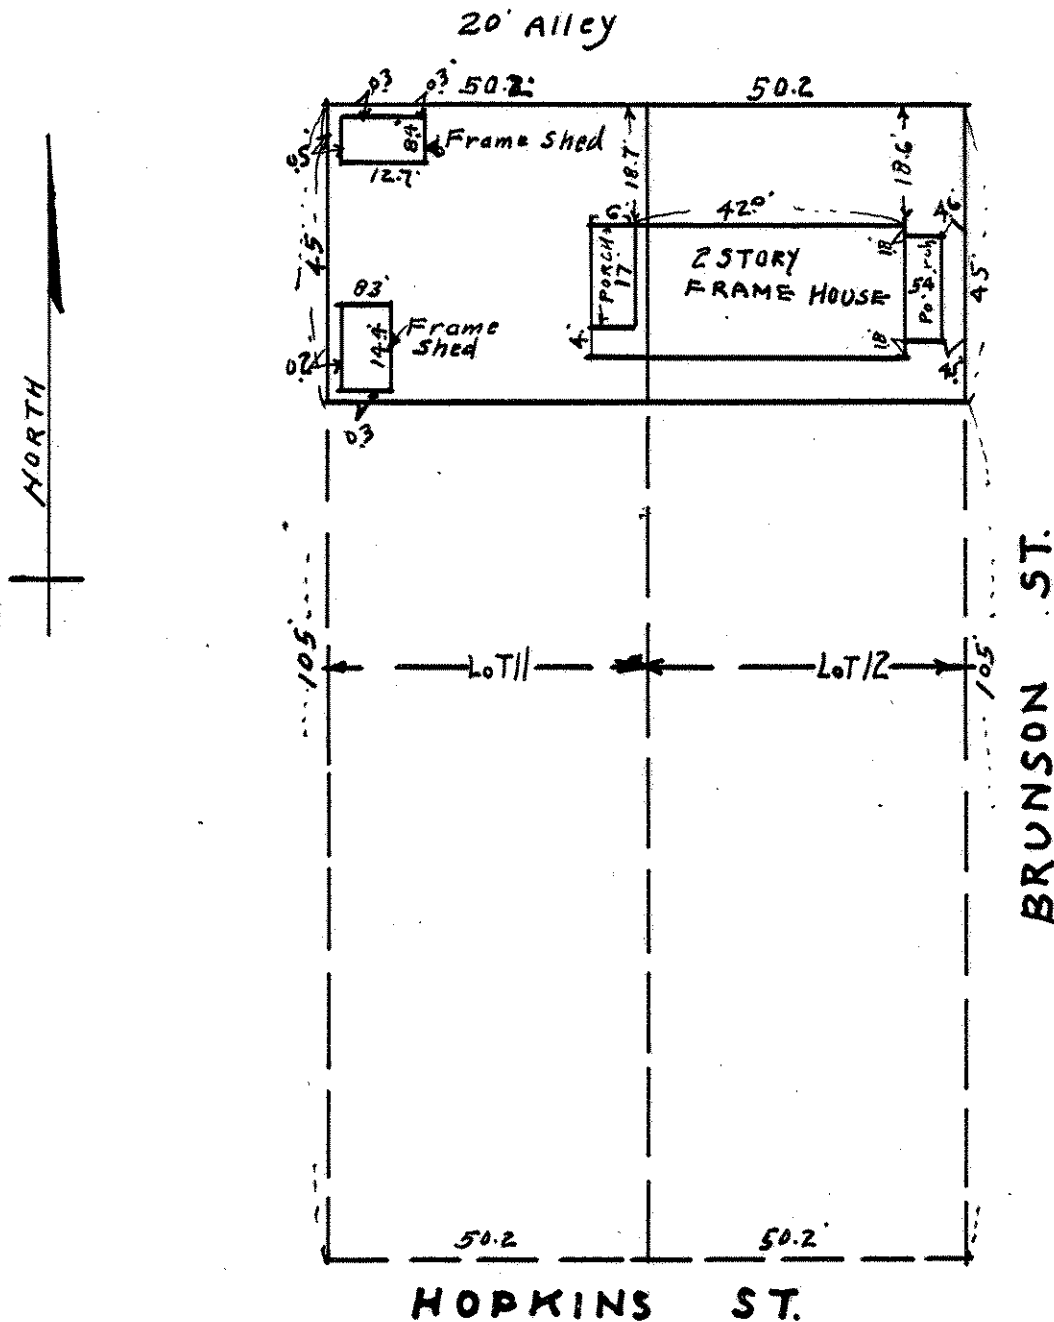

## CERTIFICATE OF LOCATION OF BUILDING

I hereby certify that on April, 10, 1936  
 I made a survey of the location of the building on the above  
 described property and that the location of said building is  
 correctly shown on the above plat.

*T. J. Welch*

## CERTIFICATE OF SURVEY

I hereby certify that on April, 10, 1936  
 I surveyed the property described above and that the above  
 plat is a correct representation of said survey.

*T. J. Welch*