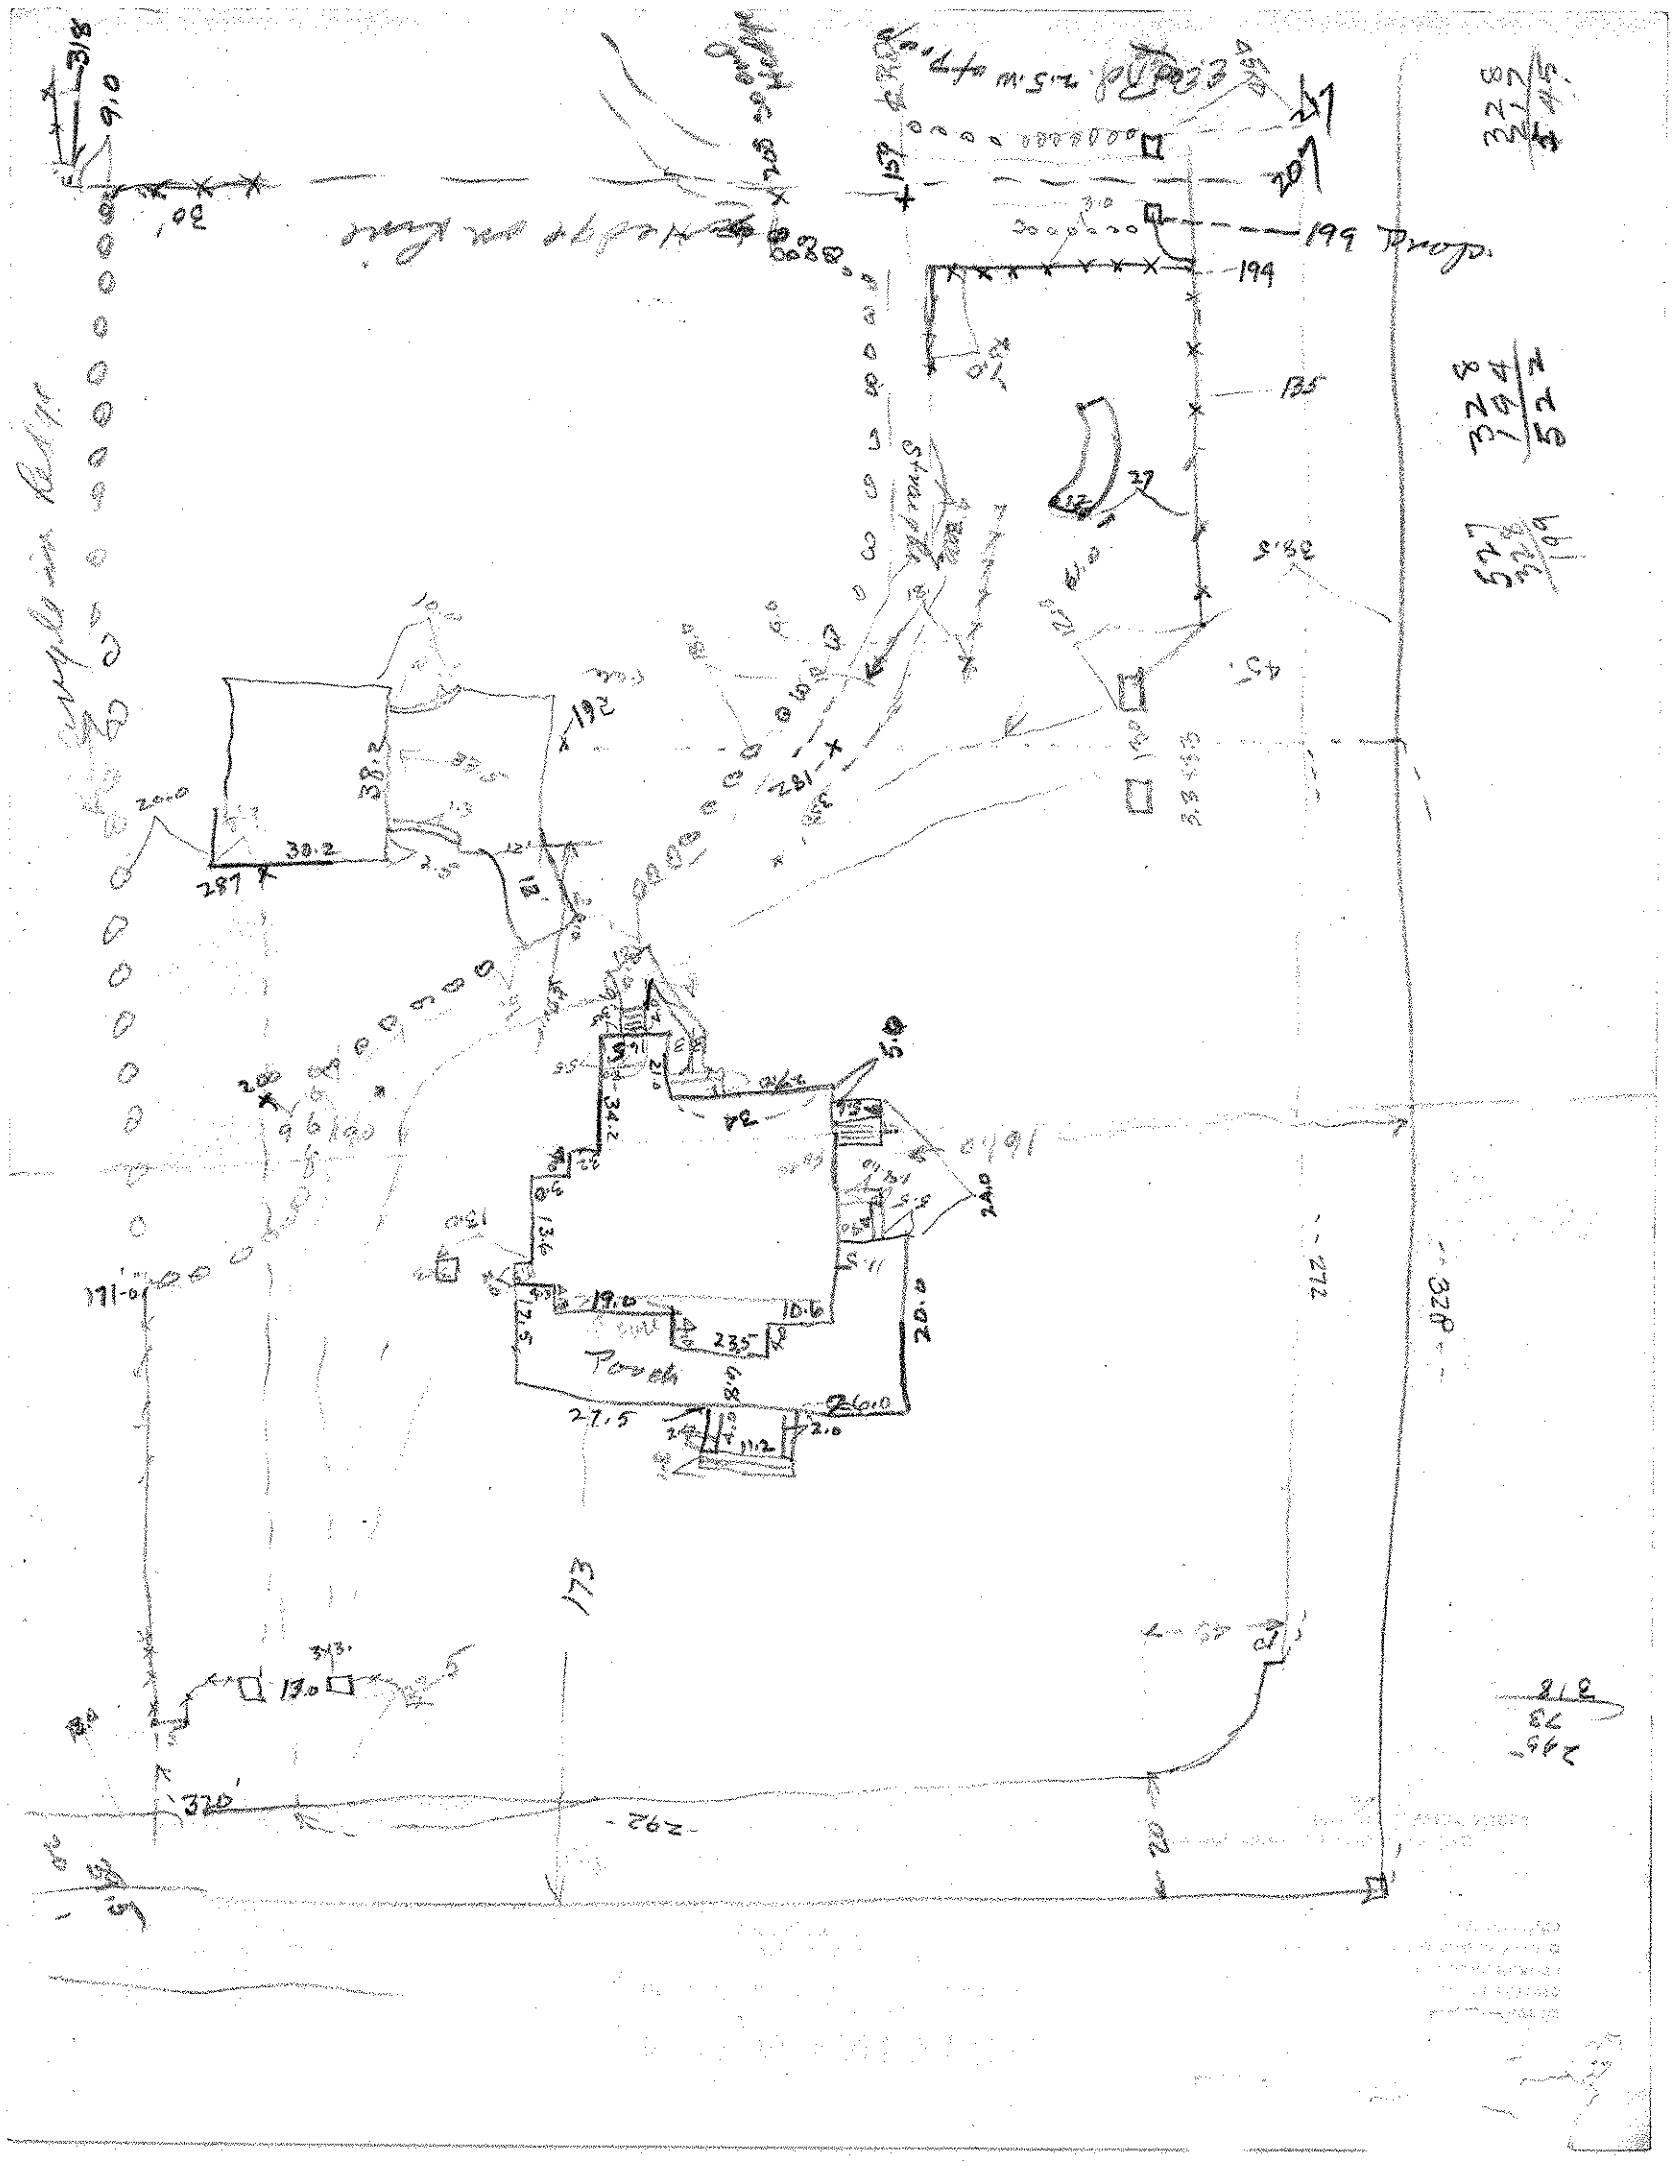
199 Propo.
199
135
45'
192
281
287
30.2
38.2
Porch
173
320'
292
272
320'