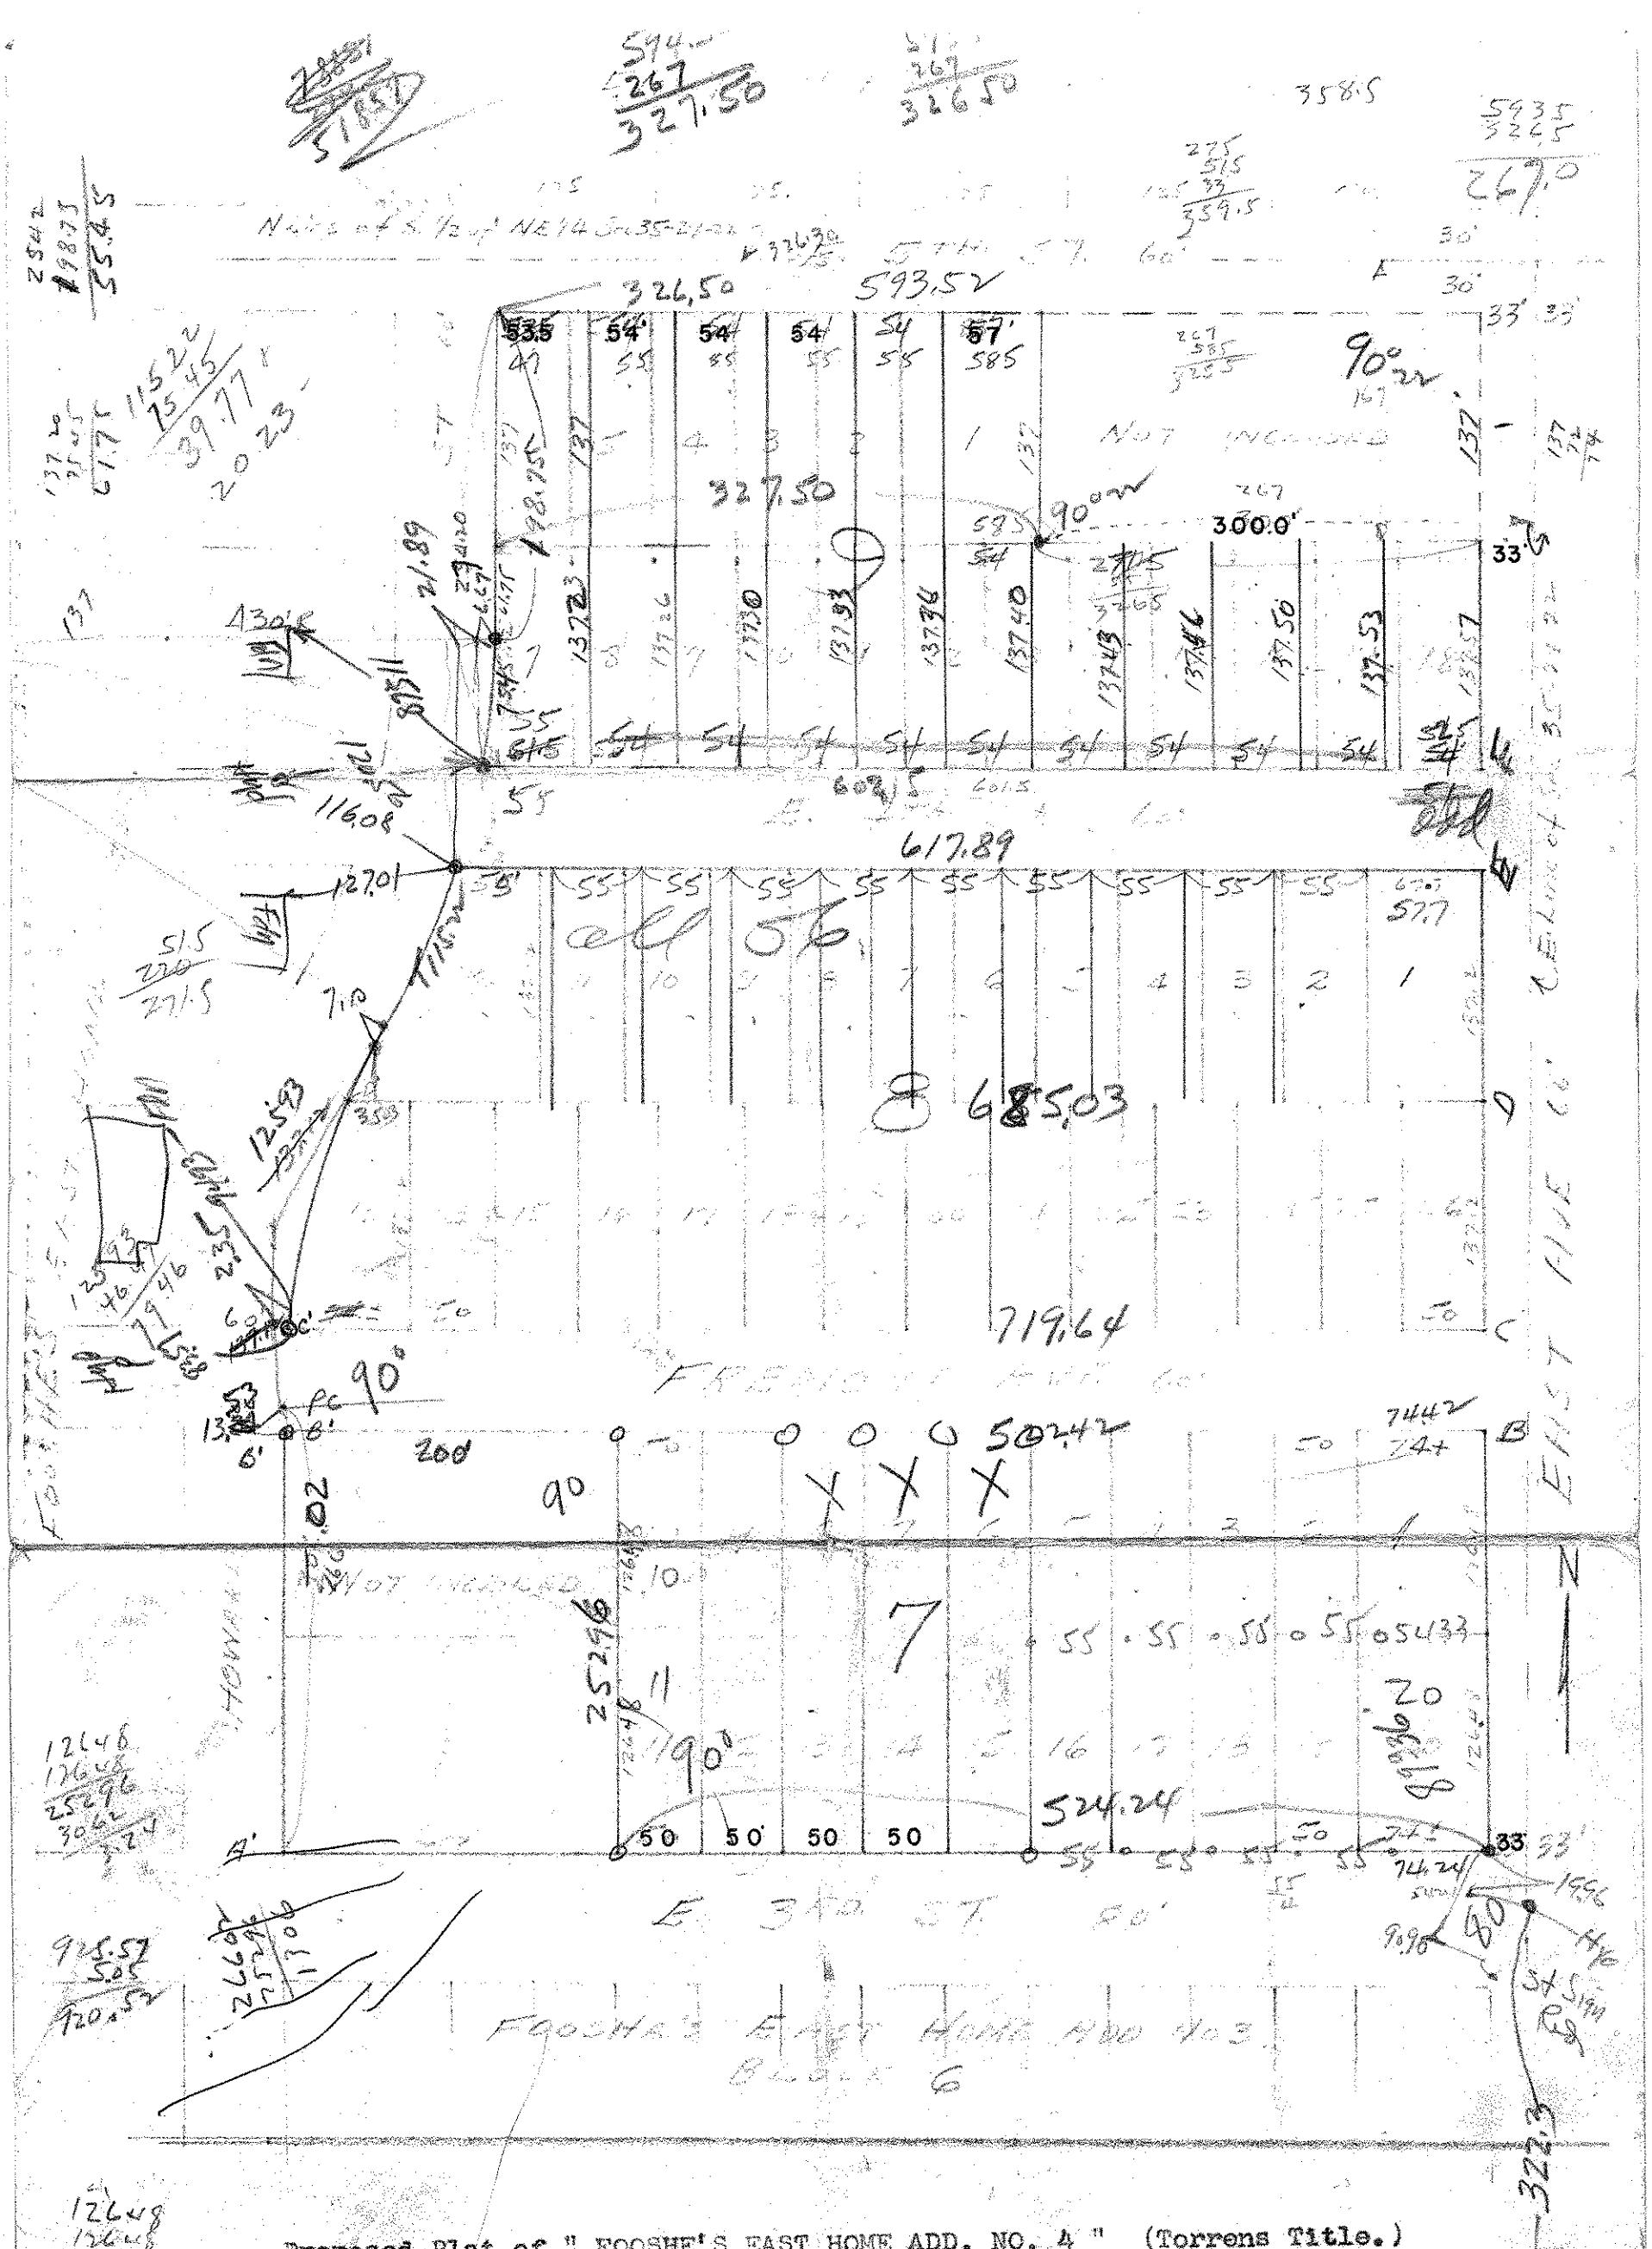

Proposed Plat of " FOOSHE'S EAST HOME ADD. NO. 4 " (Torrens Title.)

All of that part of the East three-fourths (E.3/4) of the South one-half(S.1/2) of the Northeast quarter (NE 1/4) of Sec. 35, Township 29, Range 22, North of the N. line of Third St., Except Fooshe's East Home Add., and except the N. 167 feet of the East 300 feet theteof, and also except-~~except-t~~hat part of the Southeast quarter (SE 1/4) of the NE quarter (NE1/4) of Sec. 35 T. 29 R. 22 bounded as follows; on the West by the East line of Howard St. on the East by a line 200 feet East and parallel with the said East line of Howard St; on the South by the North line of Third St. and on the North by an extension of the Southerly line of Fremont Ave.

Owners Peter E. and Katherine V. Fooshe and Louis V. and Elise Kummert Sauer, all of St. Paul, Minn.

Harold Purtell, Reg. Surveyor. 317 Hamm Bldg. St. Paul, Minn.