PHONE 735-4343

1903 E. MINNEHAHA AVE.
ST. PAUL, MN. 55119

WARREN I. FORSBERG, REGISTERED LAND SURVEYOR
DBA

LAKE & LAND SURVEYING CO.

SURVEY FOR CLARENCE SEIDEL

Lots 27, 28, 29 and 30, Block 21, A. Gotzians Rearrangement

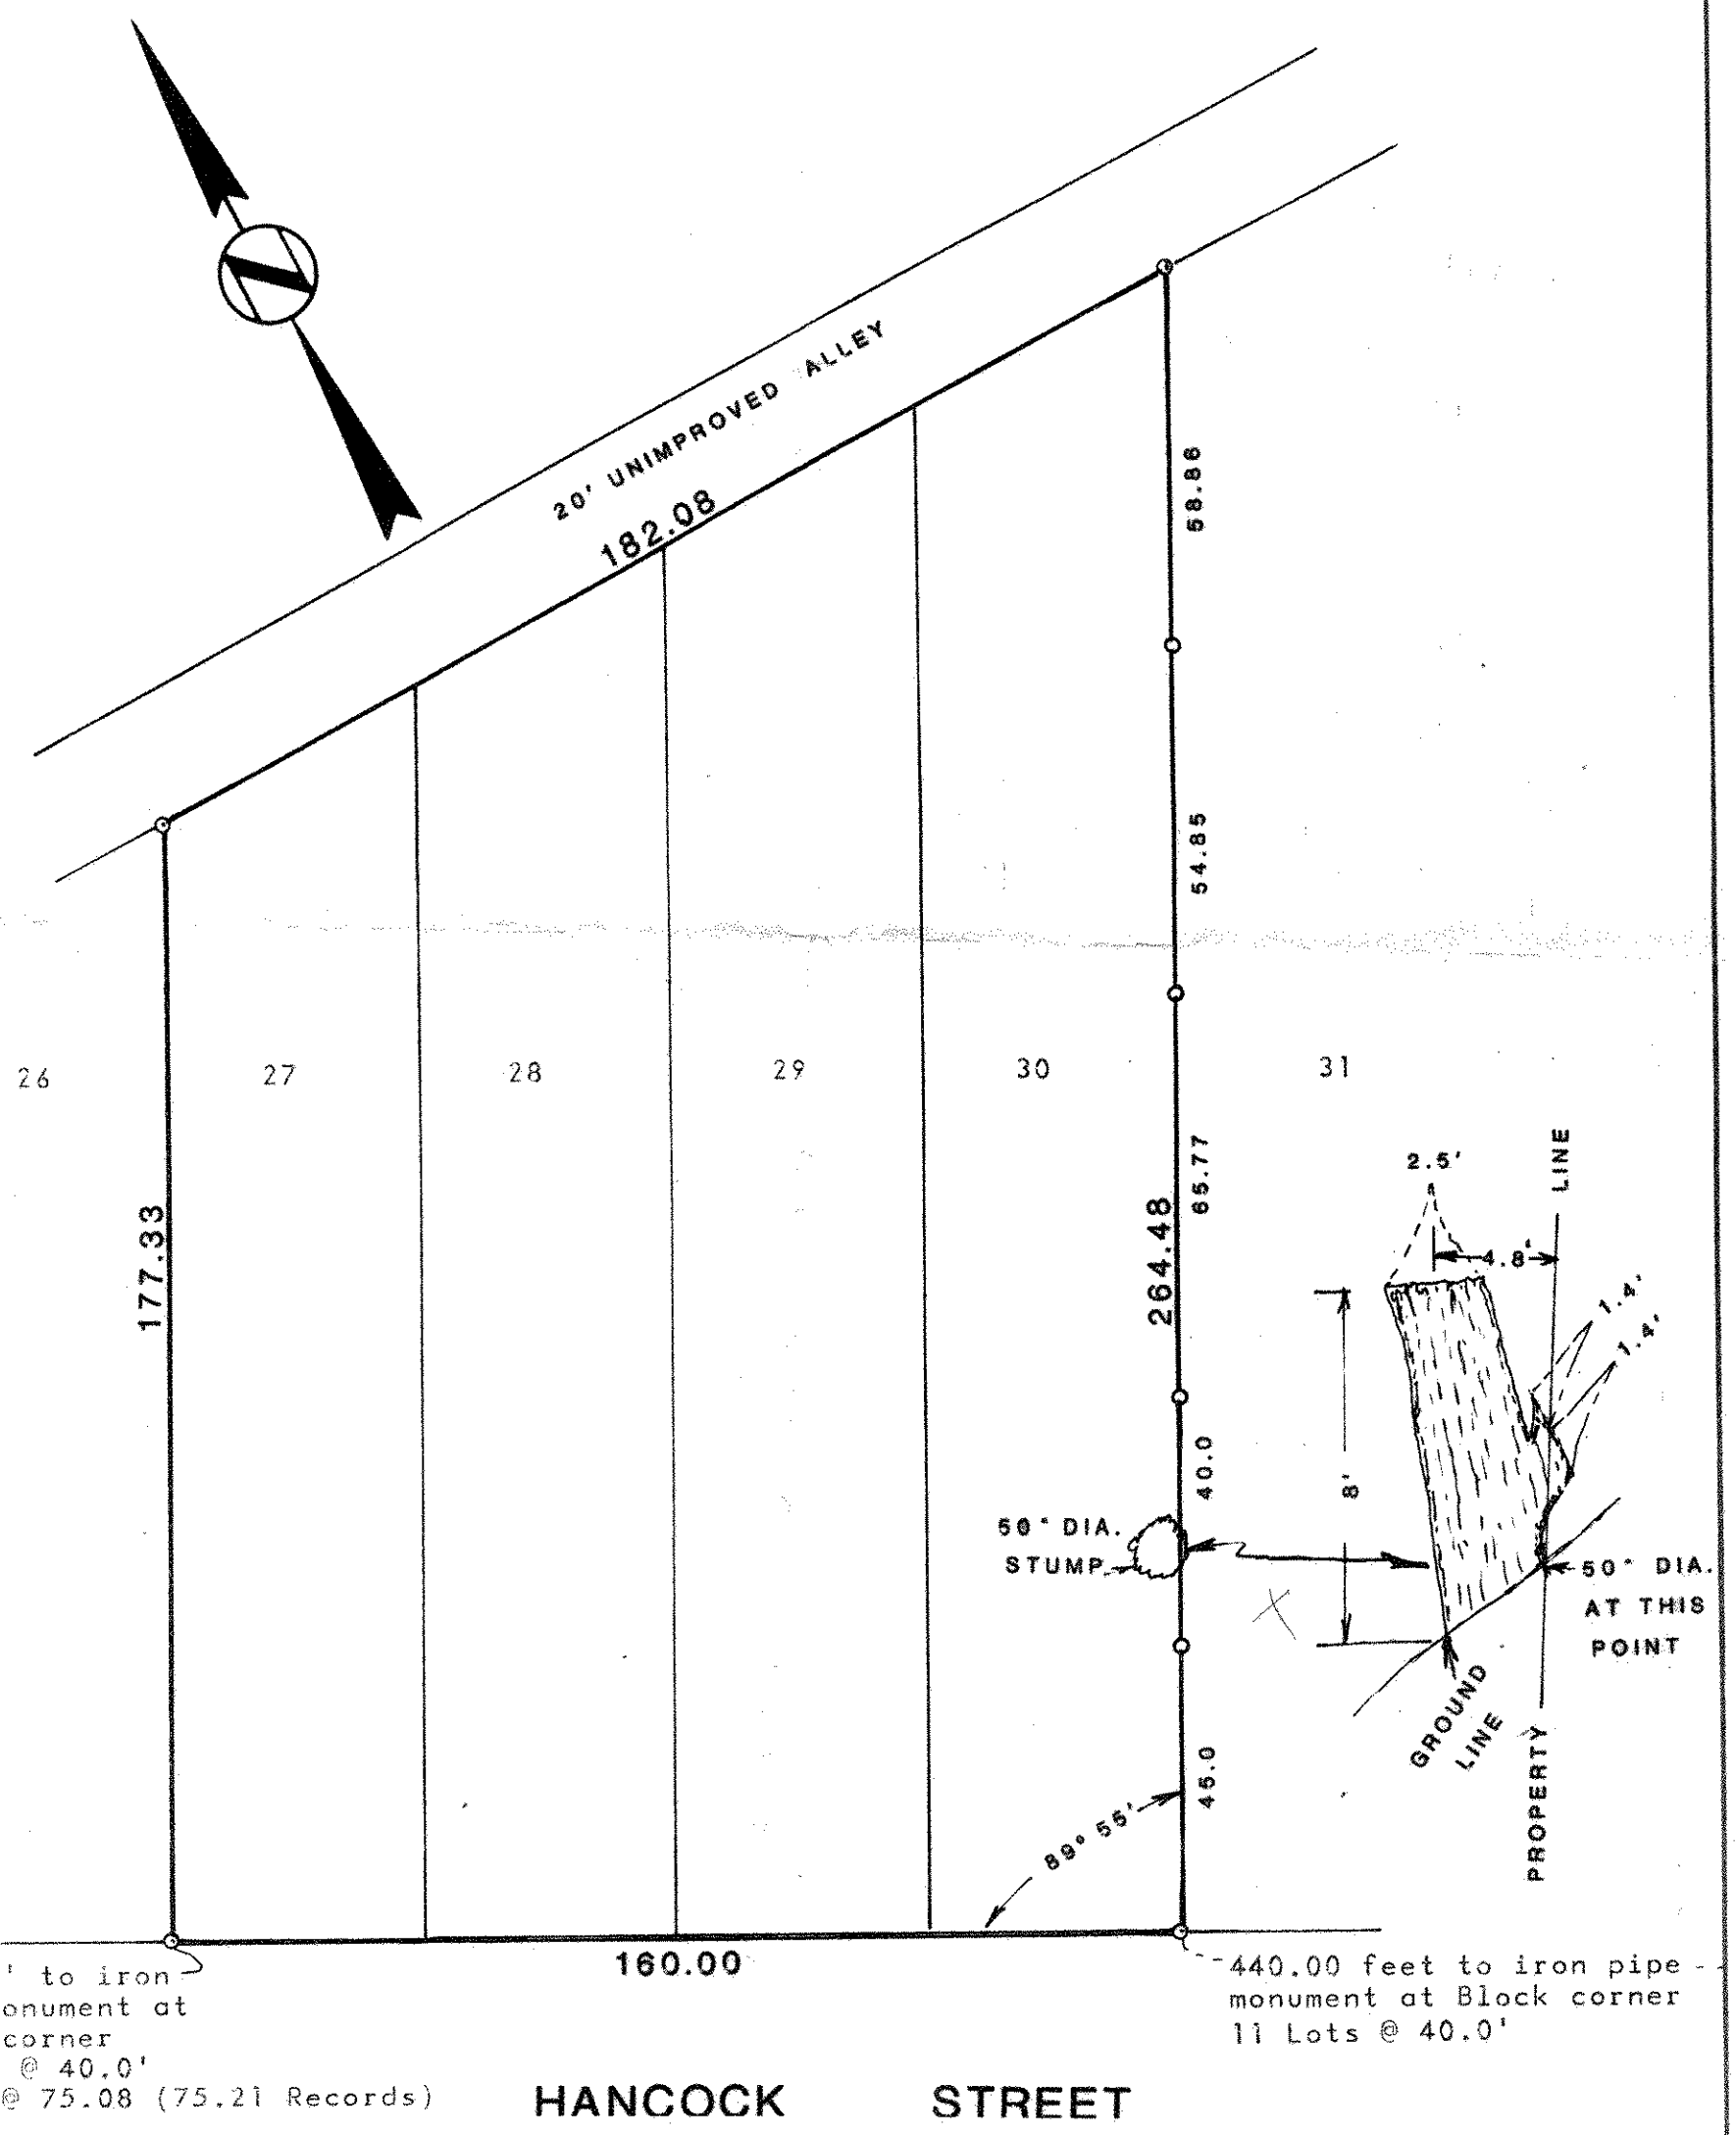

I HEREBY CERTIFY THAT THIS SURVEY WAS PREPARED BY ME OR UNDER MY DIRECT SUPERVISION AND THAT I AM A DULY REGISTERED LAND SURVEYOR UNDER THE LAWS OF THE STATE OF MINNESOTA.

SIGNED [signature]

DATE May 22, 1979

REGISTRATION NO. 4840 MINN. & S-1162 WISC.

SCALE 1 INCH = 30 FEET

O - INDICATES IRON MONUMENT SET

● - INDICATES IRON MONUMENT FOUND