Phone 735-4343

WARREN I. FORSBERG
Registered Land Surveyor

2141 E. 5th Street
St. Paul, Minn.
55119

SURVEY FOR: ALL-STATE PROP.

described as: LOT 40, BLOCK 21, OF A. GOTZIAN'S REA. OF SIGEL'S ADD.

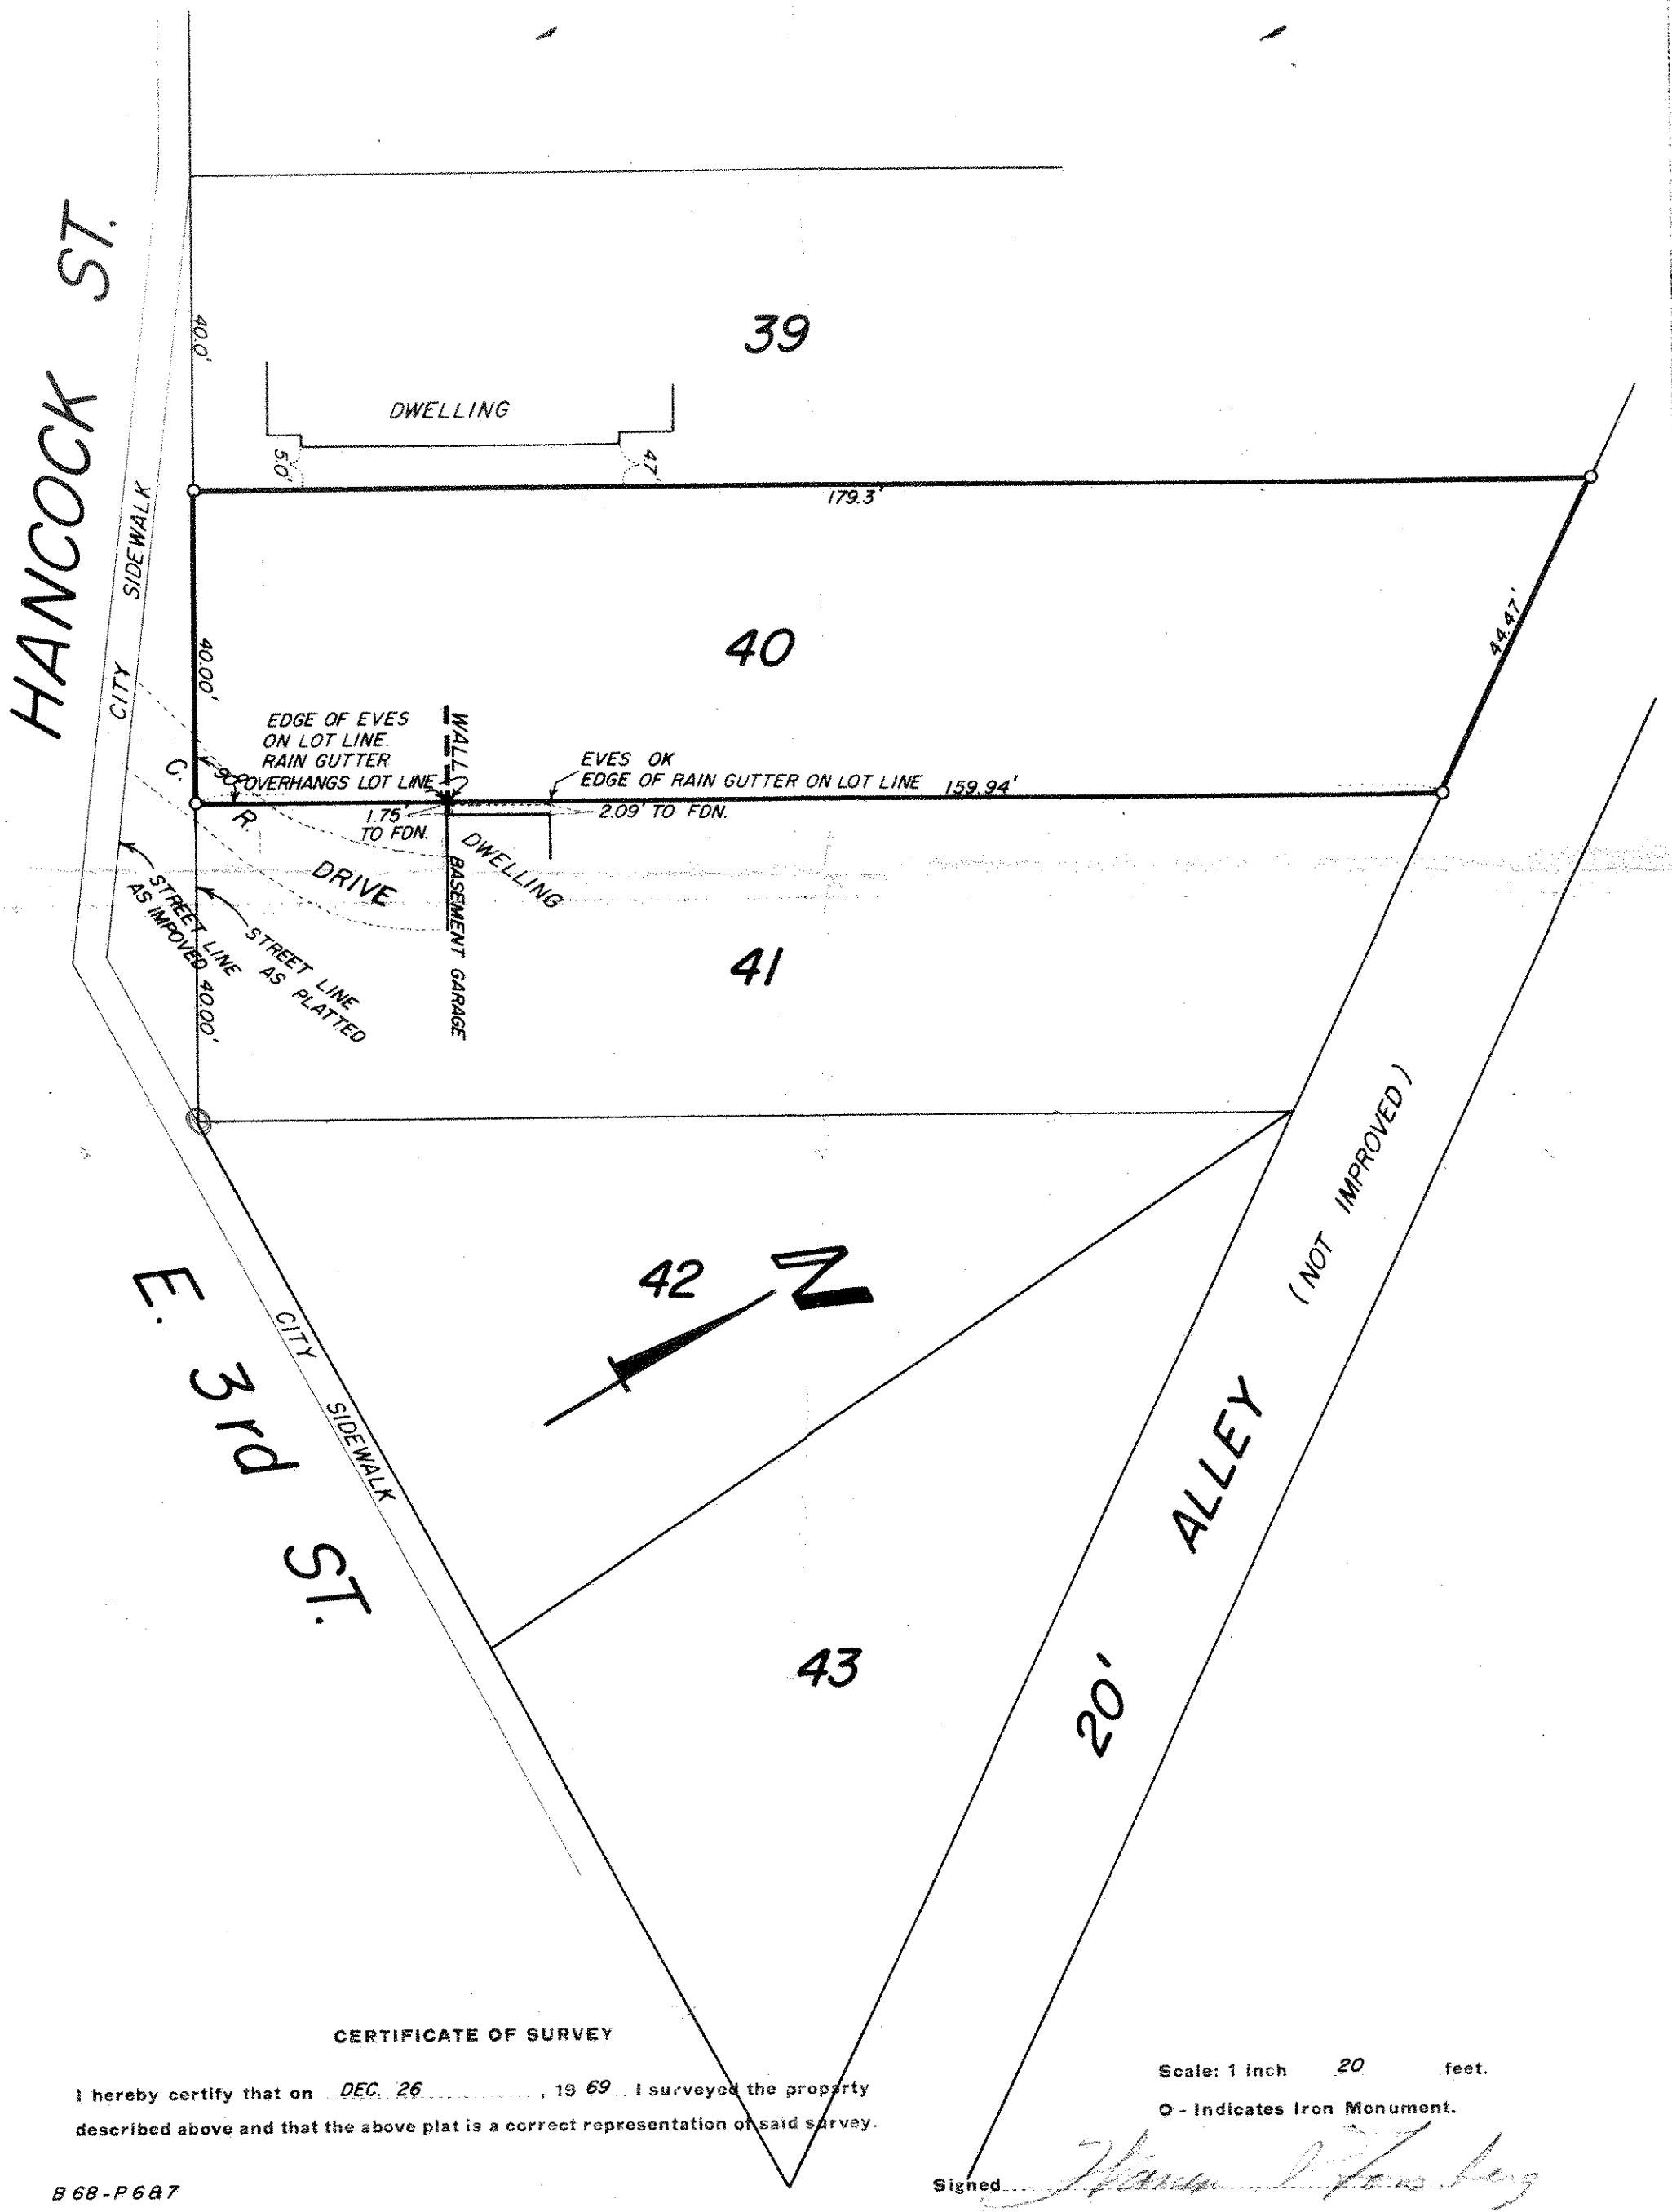

CERTIFICATE OF SURVEY

I hereby certify that on DEC. 26, 19 69 I surveyed the property described above and that the above plat is a correct representation of said survey.

Scale: 1 inch 20 feet.

O - Indicates Iron Monument.

Signed Warren I. Forsberg

B 68-P 687