20 29 22

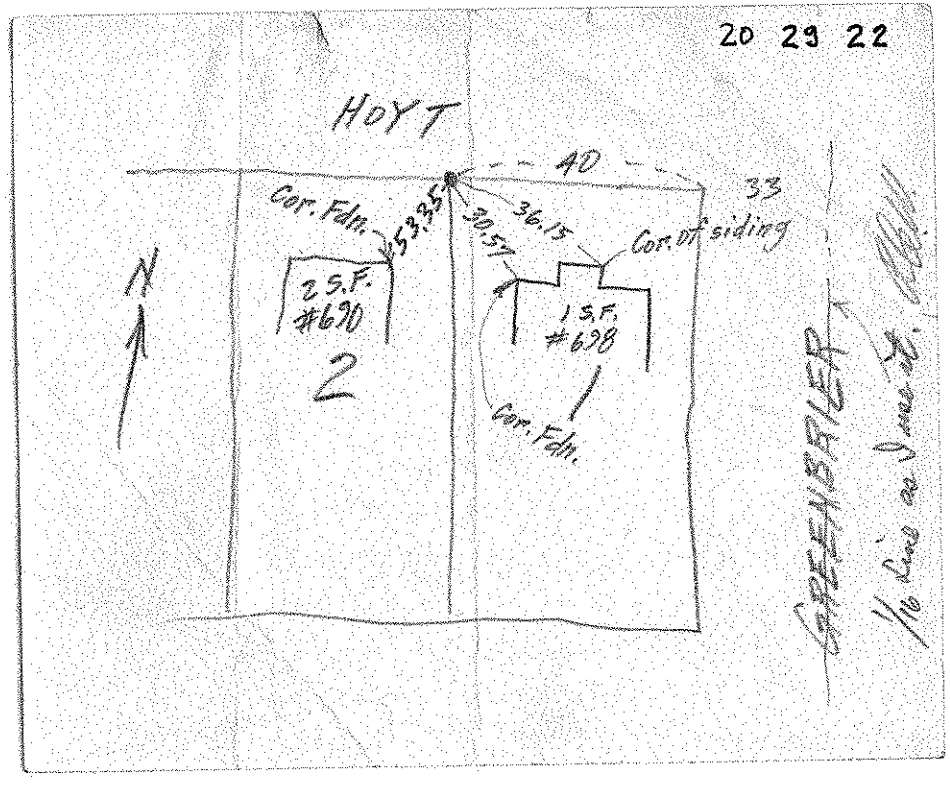

GREENBALER

1/16 Line on Dwg. 2