

PLAT OF SURVEY


Property of Department of Education, City of St. Paul, Minn.

Lots 12-13-14-15-16, Munger's Sub. of  
Block 33, Arlington Hills, St. Paul,  
Minnesota

M-5

MUNGER'S SUB. OF BLOCK 33, ARLINGTON HILLS

GREENBRIER ST 60'

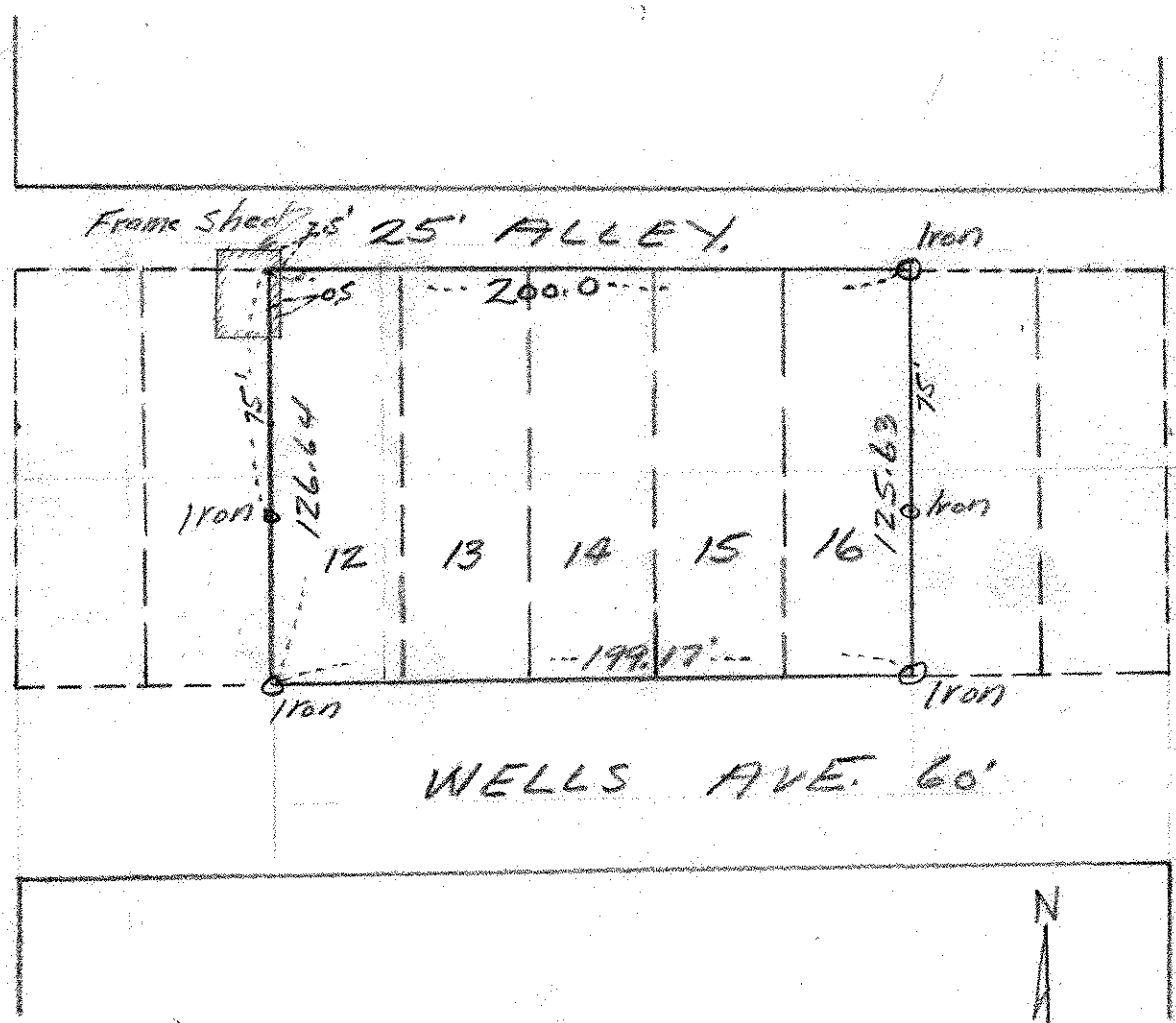

WALSH ST 60'

I. S. Forsberg,  
Chief Surveyor  
Dept. of Public Works  
St. Paul, Minnesota

Scale 1"=60'