Alley- Openings

in Blocks 31 & 40 Arlington Hill Addition

Scale 50' = 1"

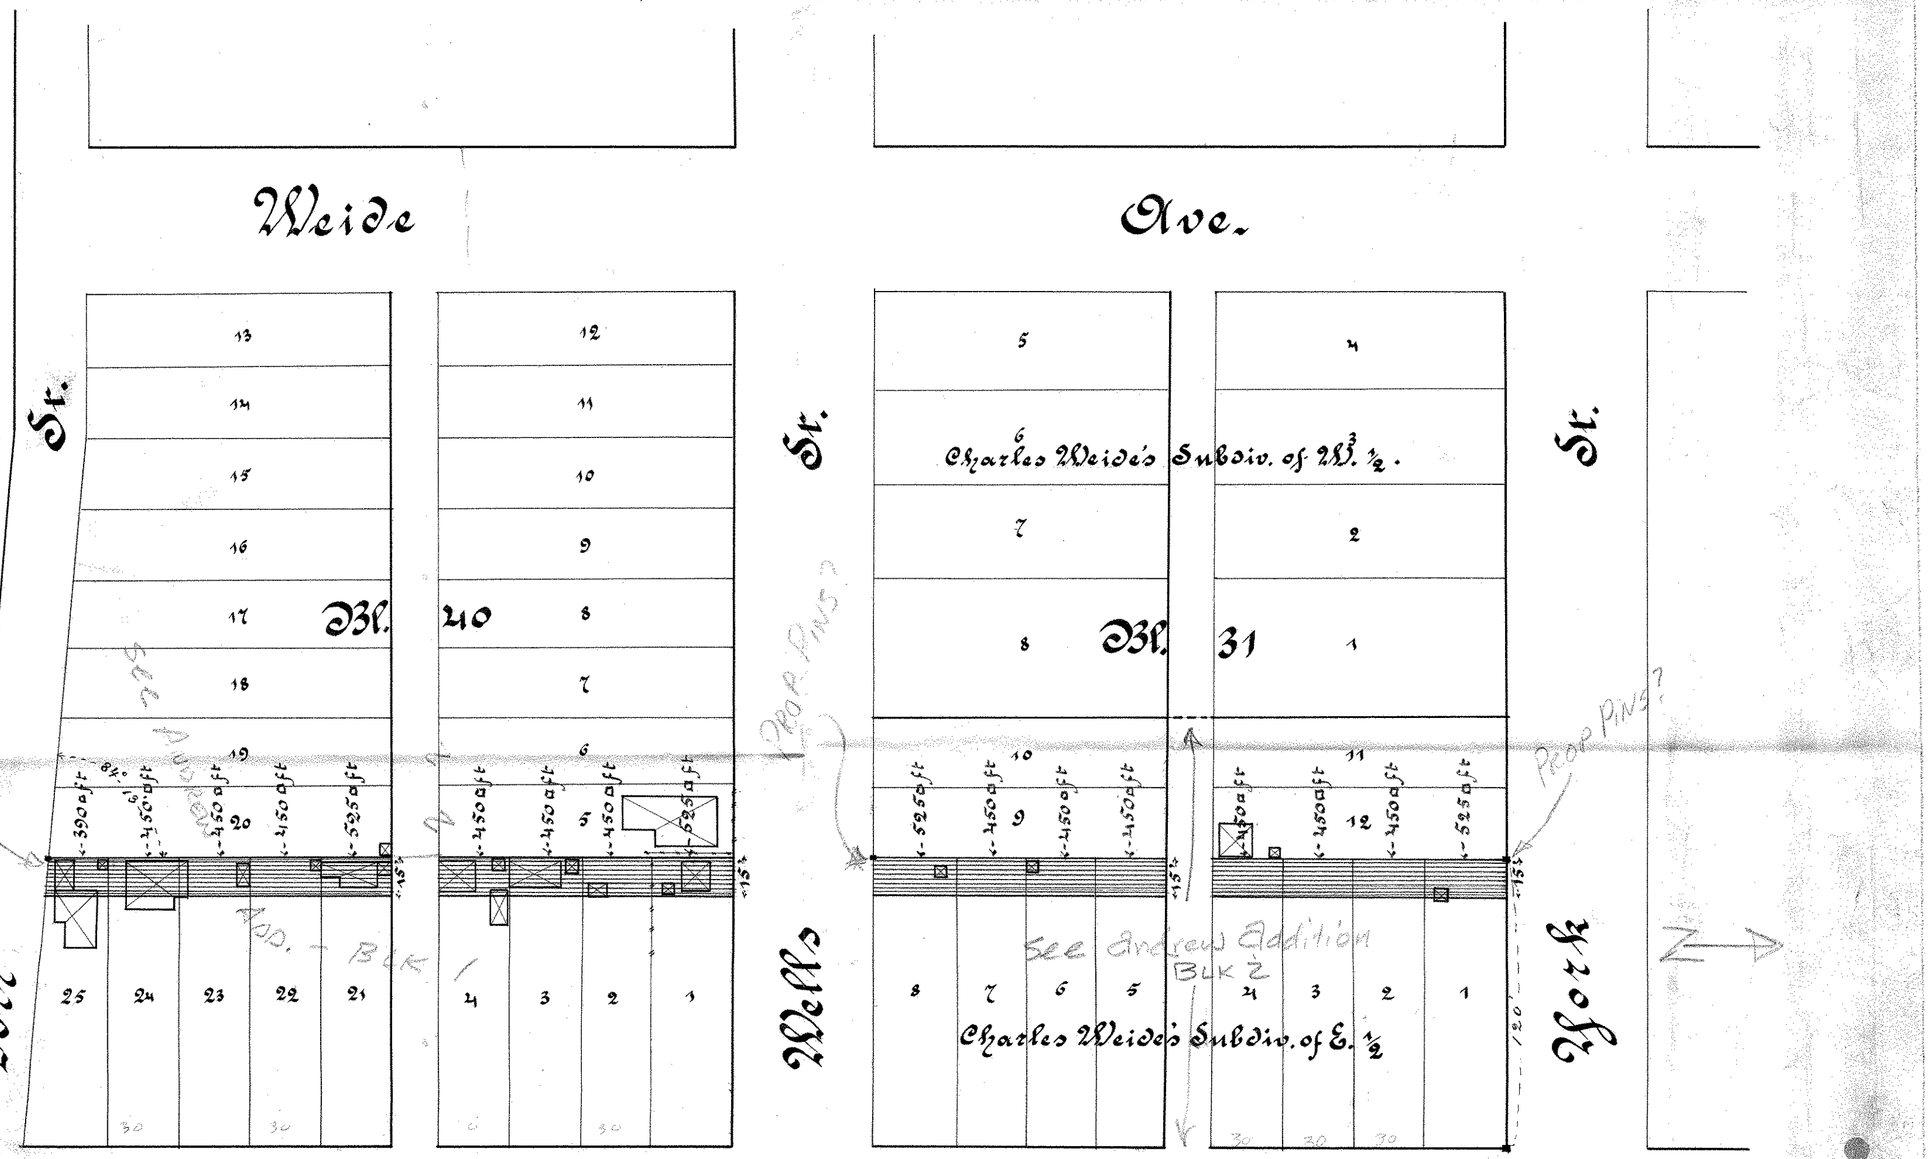
Weide
Ave.
St.
St.
St.
Dott
Wells
York
Arcade
St.
Bl. 40
Bl. 31
Charles Weide's Subdiv. of W. ½.
Charles Weide's Subdiv. of E. ½
See Andrew Addition Blk 2
Prop Pins?
Prop Pins?
