22 29 22
2658

TILSEN'S SIXTH ADDITION

ST. PAUL, MINN.

SCALE-1 INCH = 40 FEET.
o INDICATES IRON MONUMENT
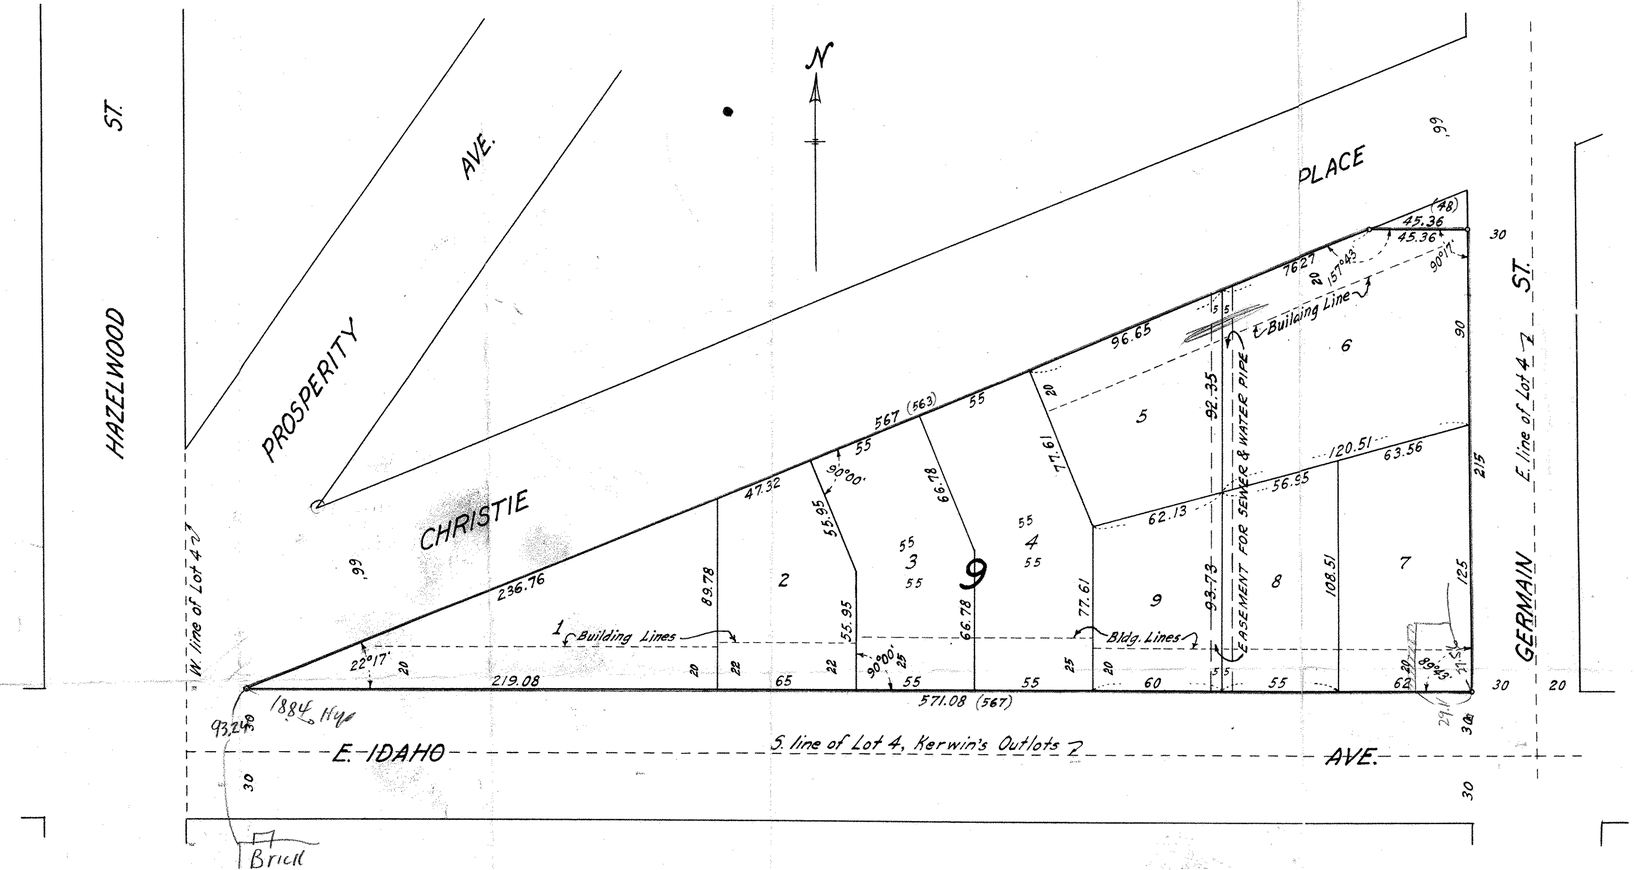
R.C. WOLFGRAM
SURVEYOR