


ENGLISH - ARLINGTON
 STORM WATER RELIEF SYSTEM
 St. Paul, Minnesota - 1962
 Scale: 1" = 100'
 Sheet 1 of 2
 DRG:

ENGLISH - ARLINGTON SURVEY

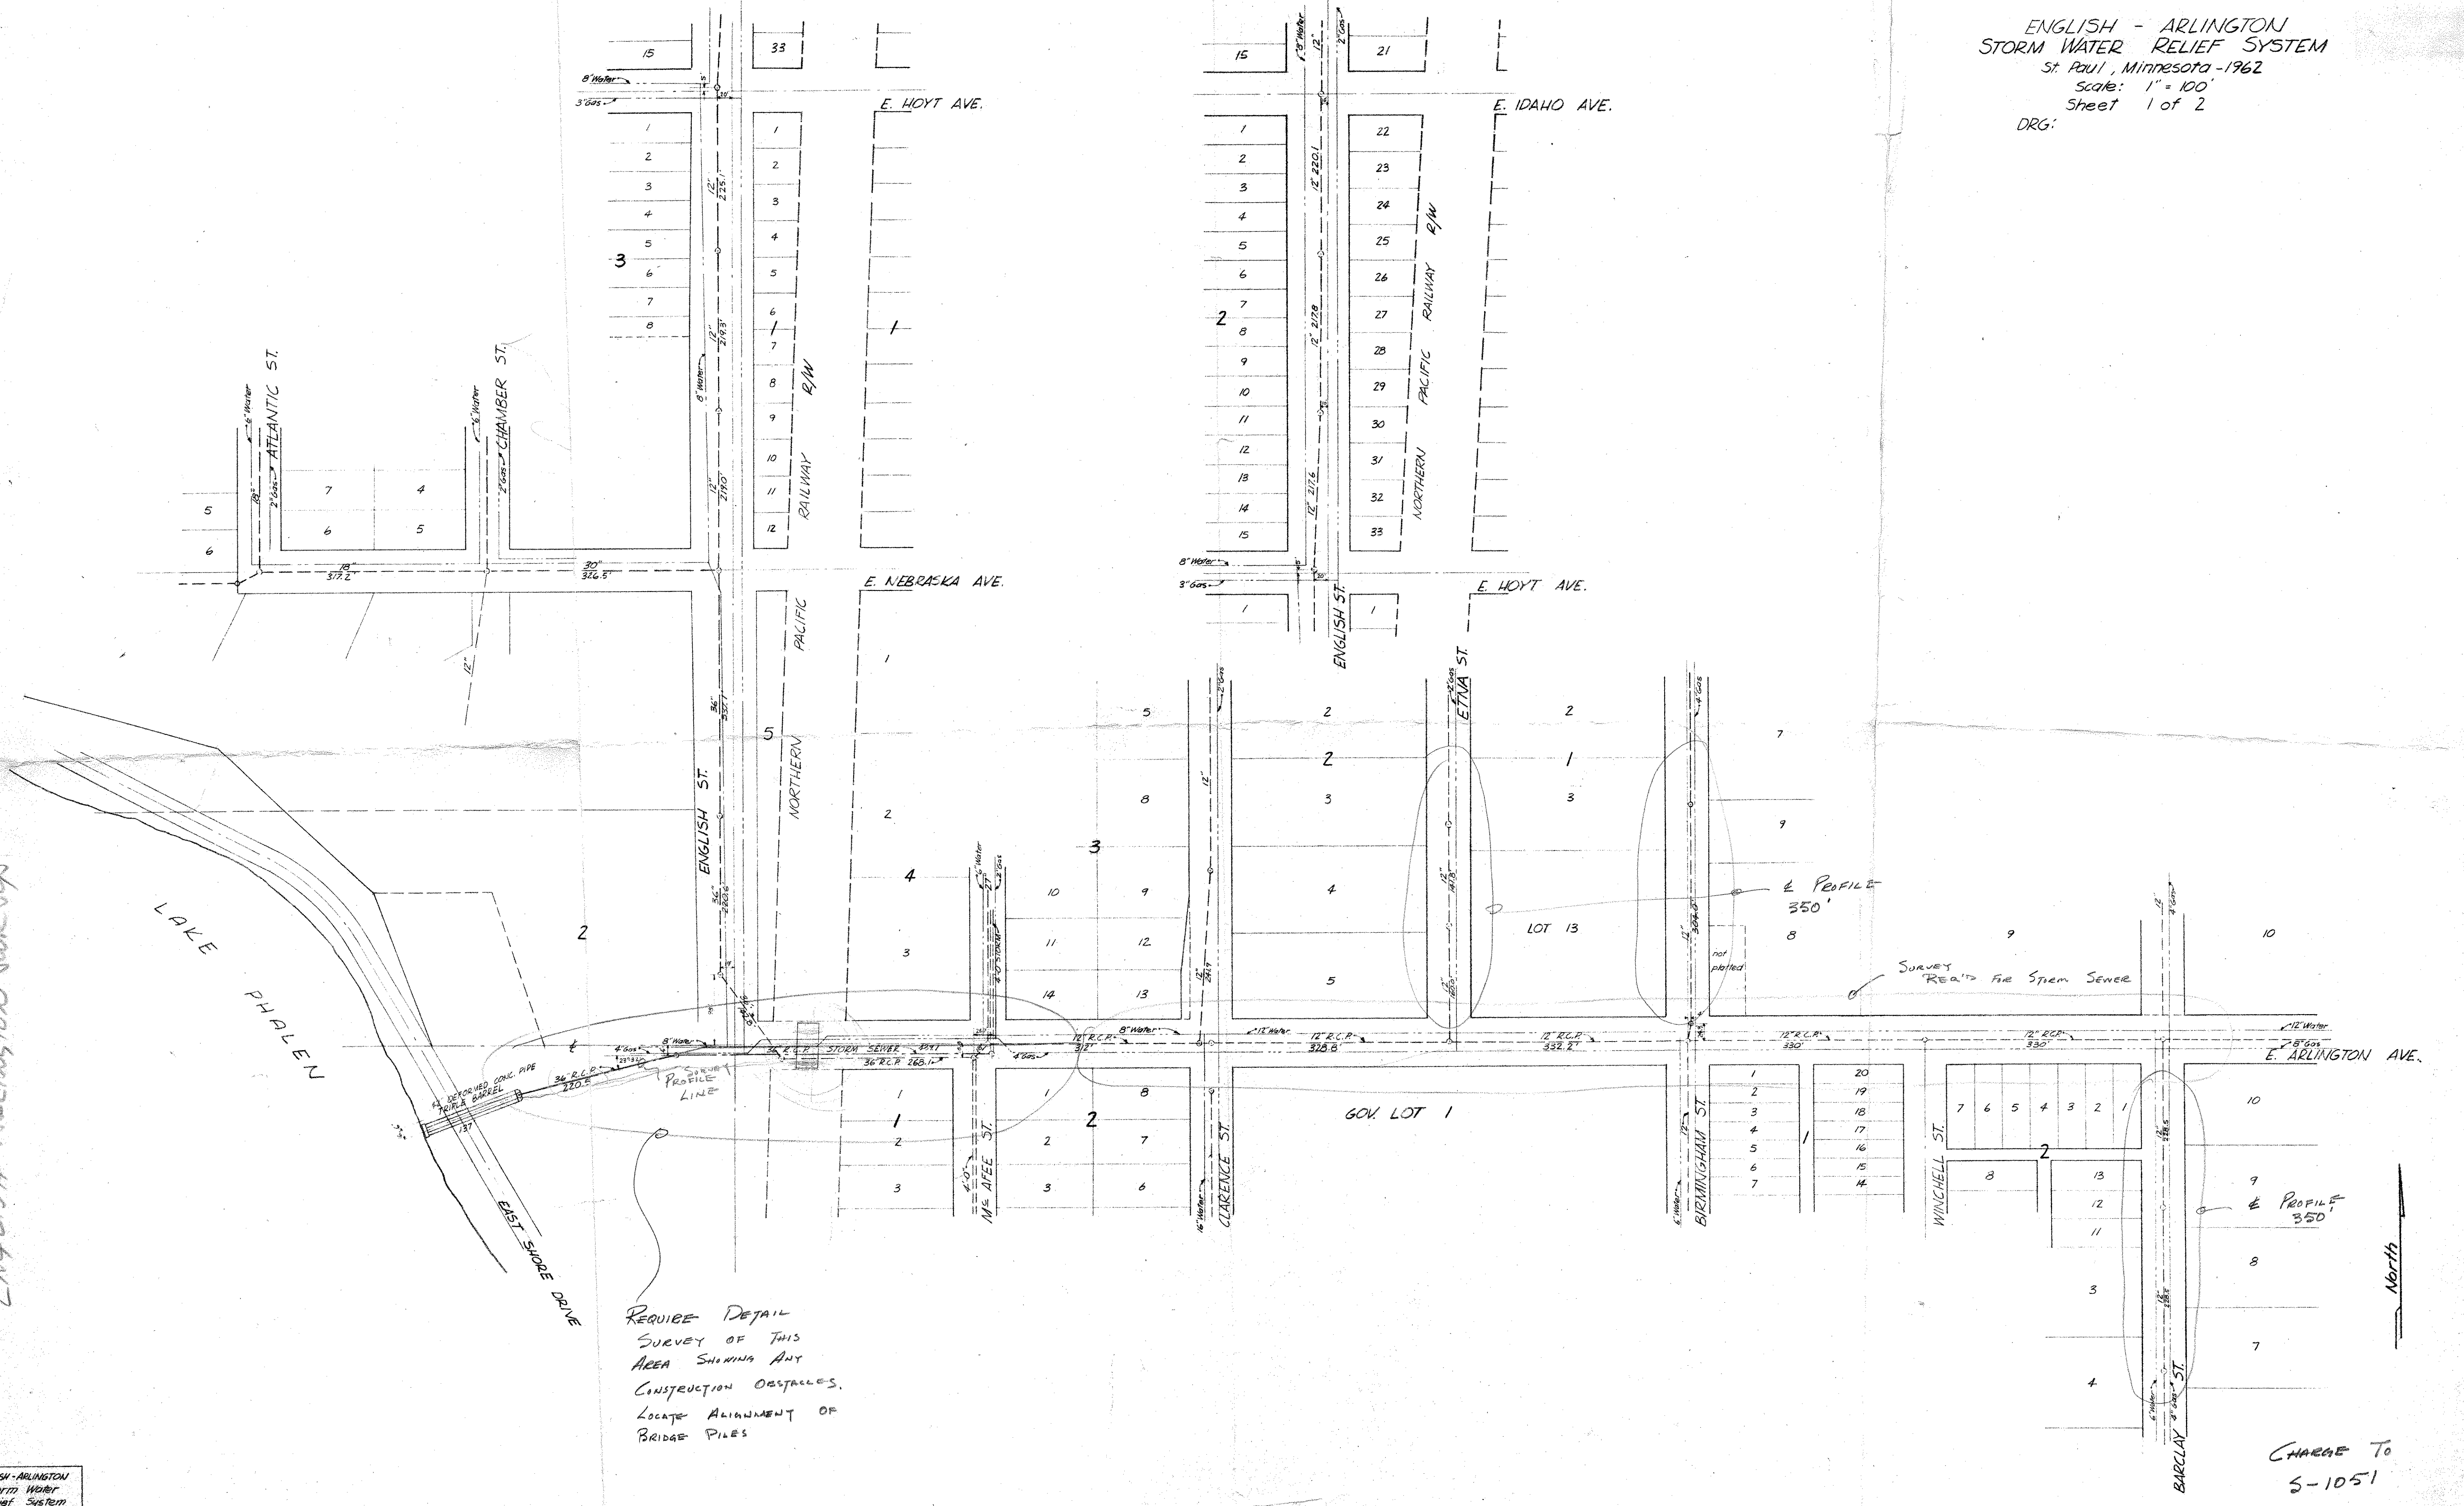

REQUIRE DETAIL
 SURVEY OF THIS
 AREA SHOWING ANY
 CONSTRUCTION OBSTACLES.
 LOCATE ALIGNMENT OF
 BRIDGE PILES

E PROFILE
 350'

SURVEY READING FIRE STERN SEWER

E PROFILE
 350'

CHARGE TO
 S-1051