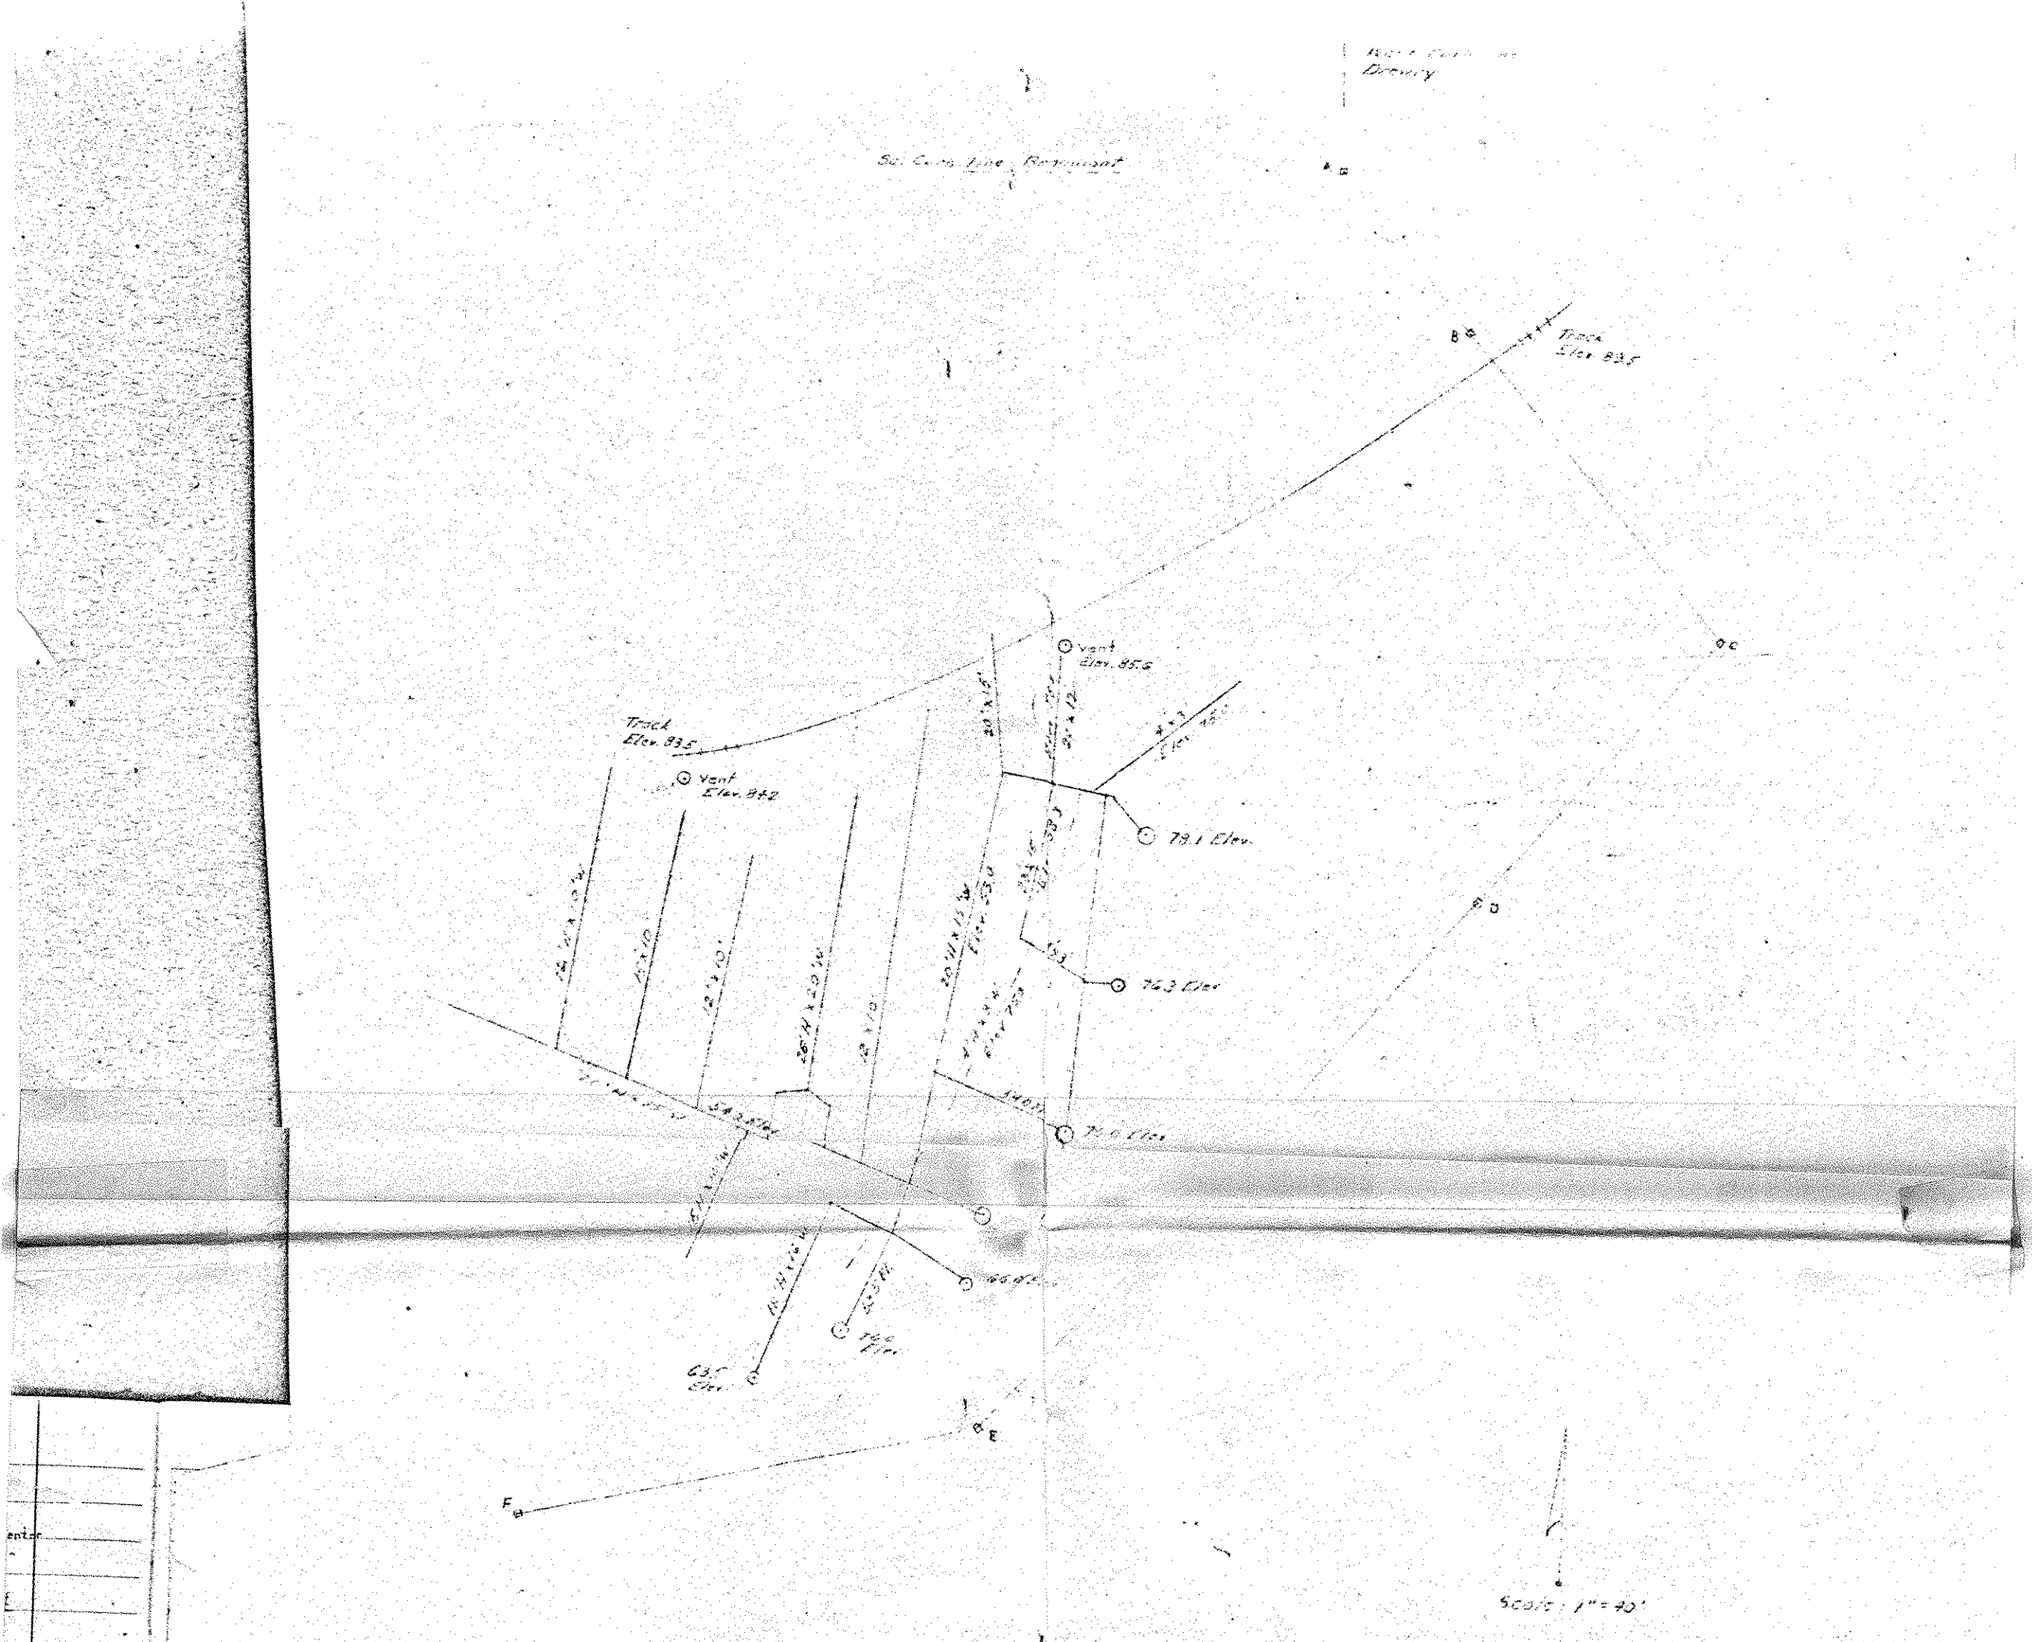
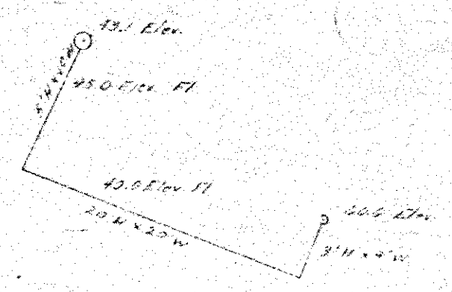
SWEDE HOLLOW
CAVE LOCATION
6-3-64