LOTS 8 & 9 BLOCK 9.

BAZIL & GUERIN'S ADD,

EXCEPT THE SOUTHERLY 115 ft.

JOHN B. IRVINE, SURVEYOR.

ST. PAUL, MINN.

JULY 26-1915

Scale 20 ft. per. inch.

I hereby certify to having surveyed lots 8 & 9. Block 9 Bazil & Guerins Addition except the S'ly 115 ft. and have located the buildings & encroachments thereon as shown by this plat and the same is correct.
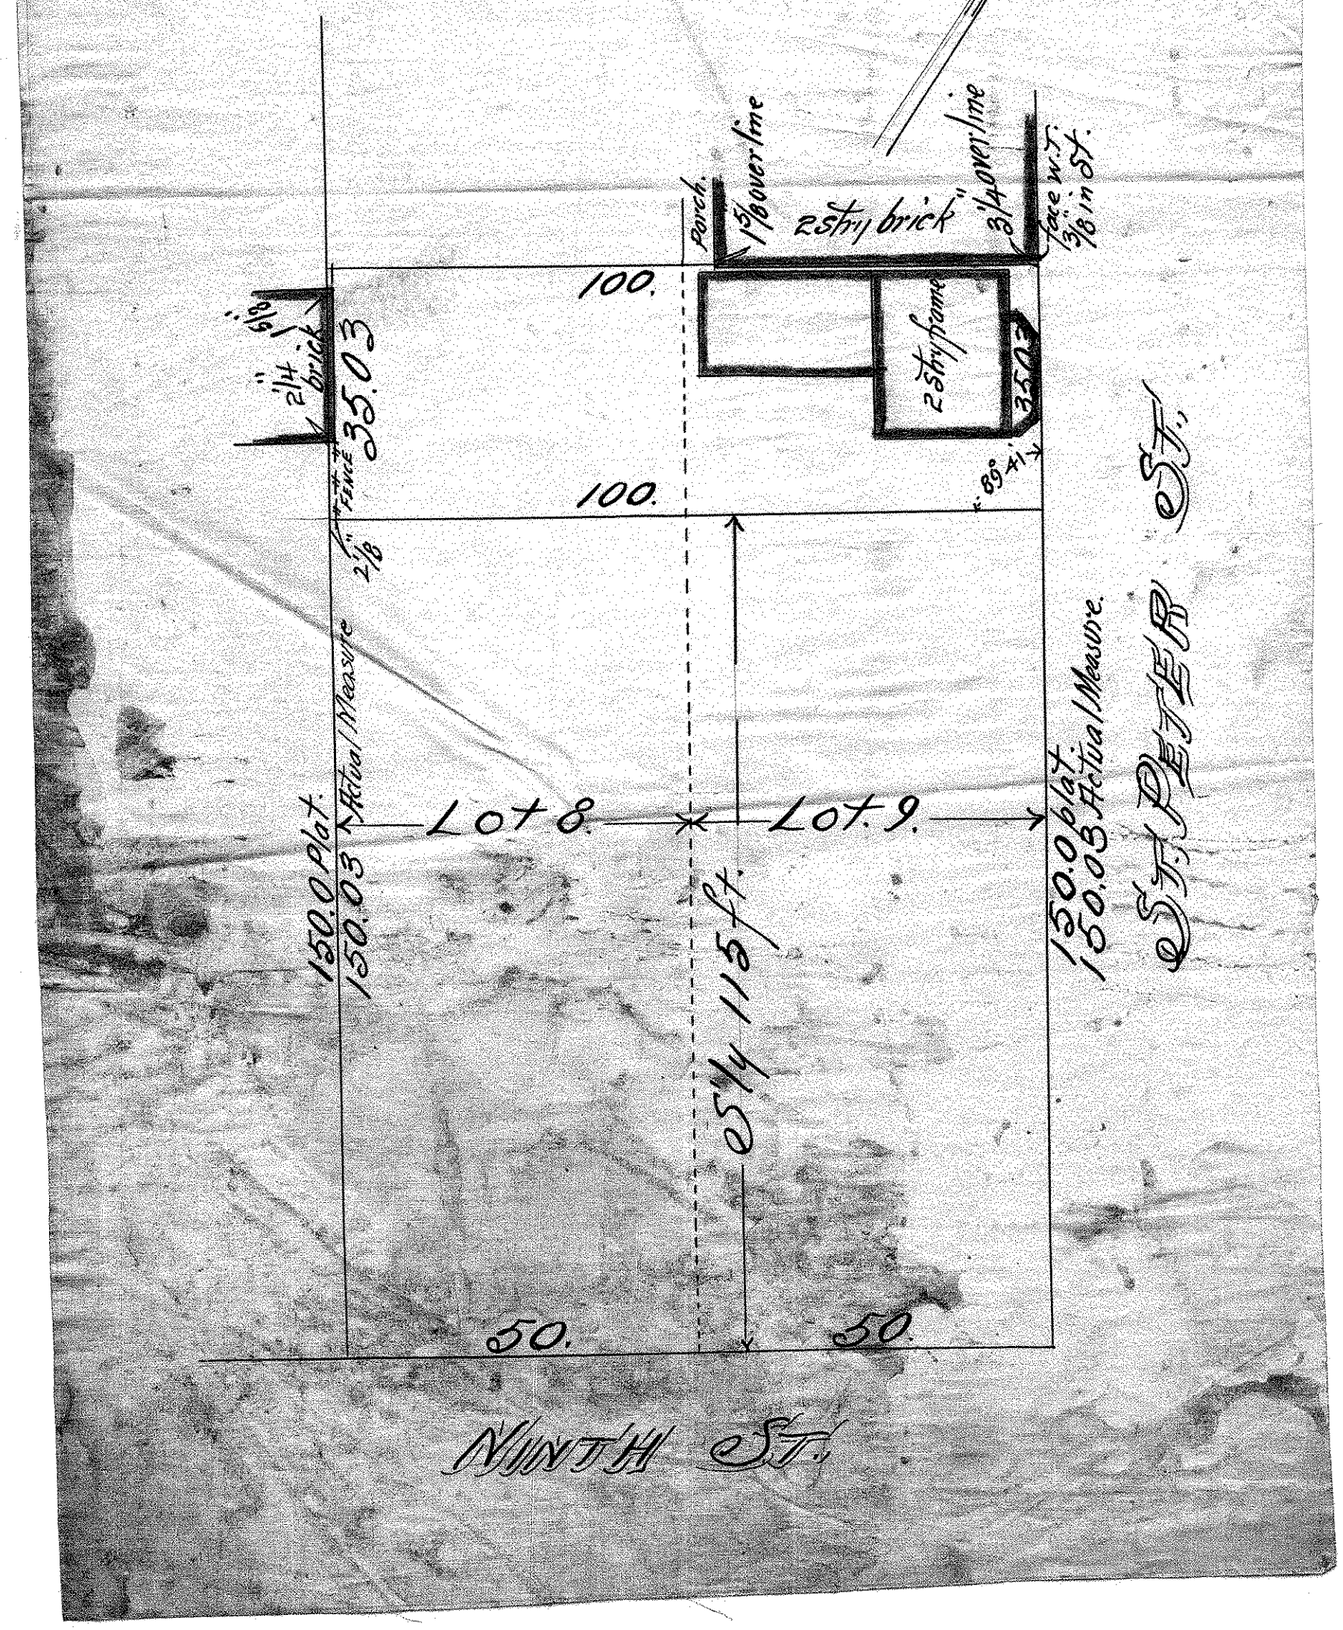
July 26-1915. John B. Irvine Surveyor.