THE WEST 3/10 OF LOT 3 & EAST 7/10 OF LOT 4, BLOCK 12 BAZILLE & GUERIN'S ADD.

JOHN B. IRVINE. SURVEYOR.
ROOM 406 GLOBE BLD'G.
ST PAUL MINN.
JAN. 13-06
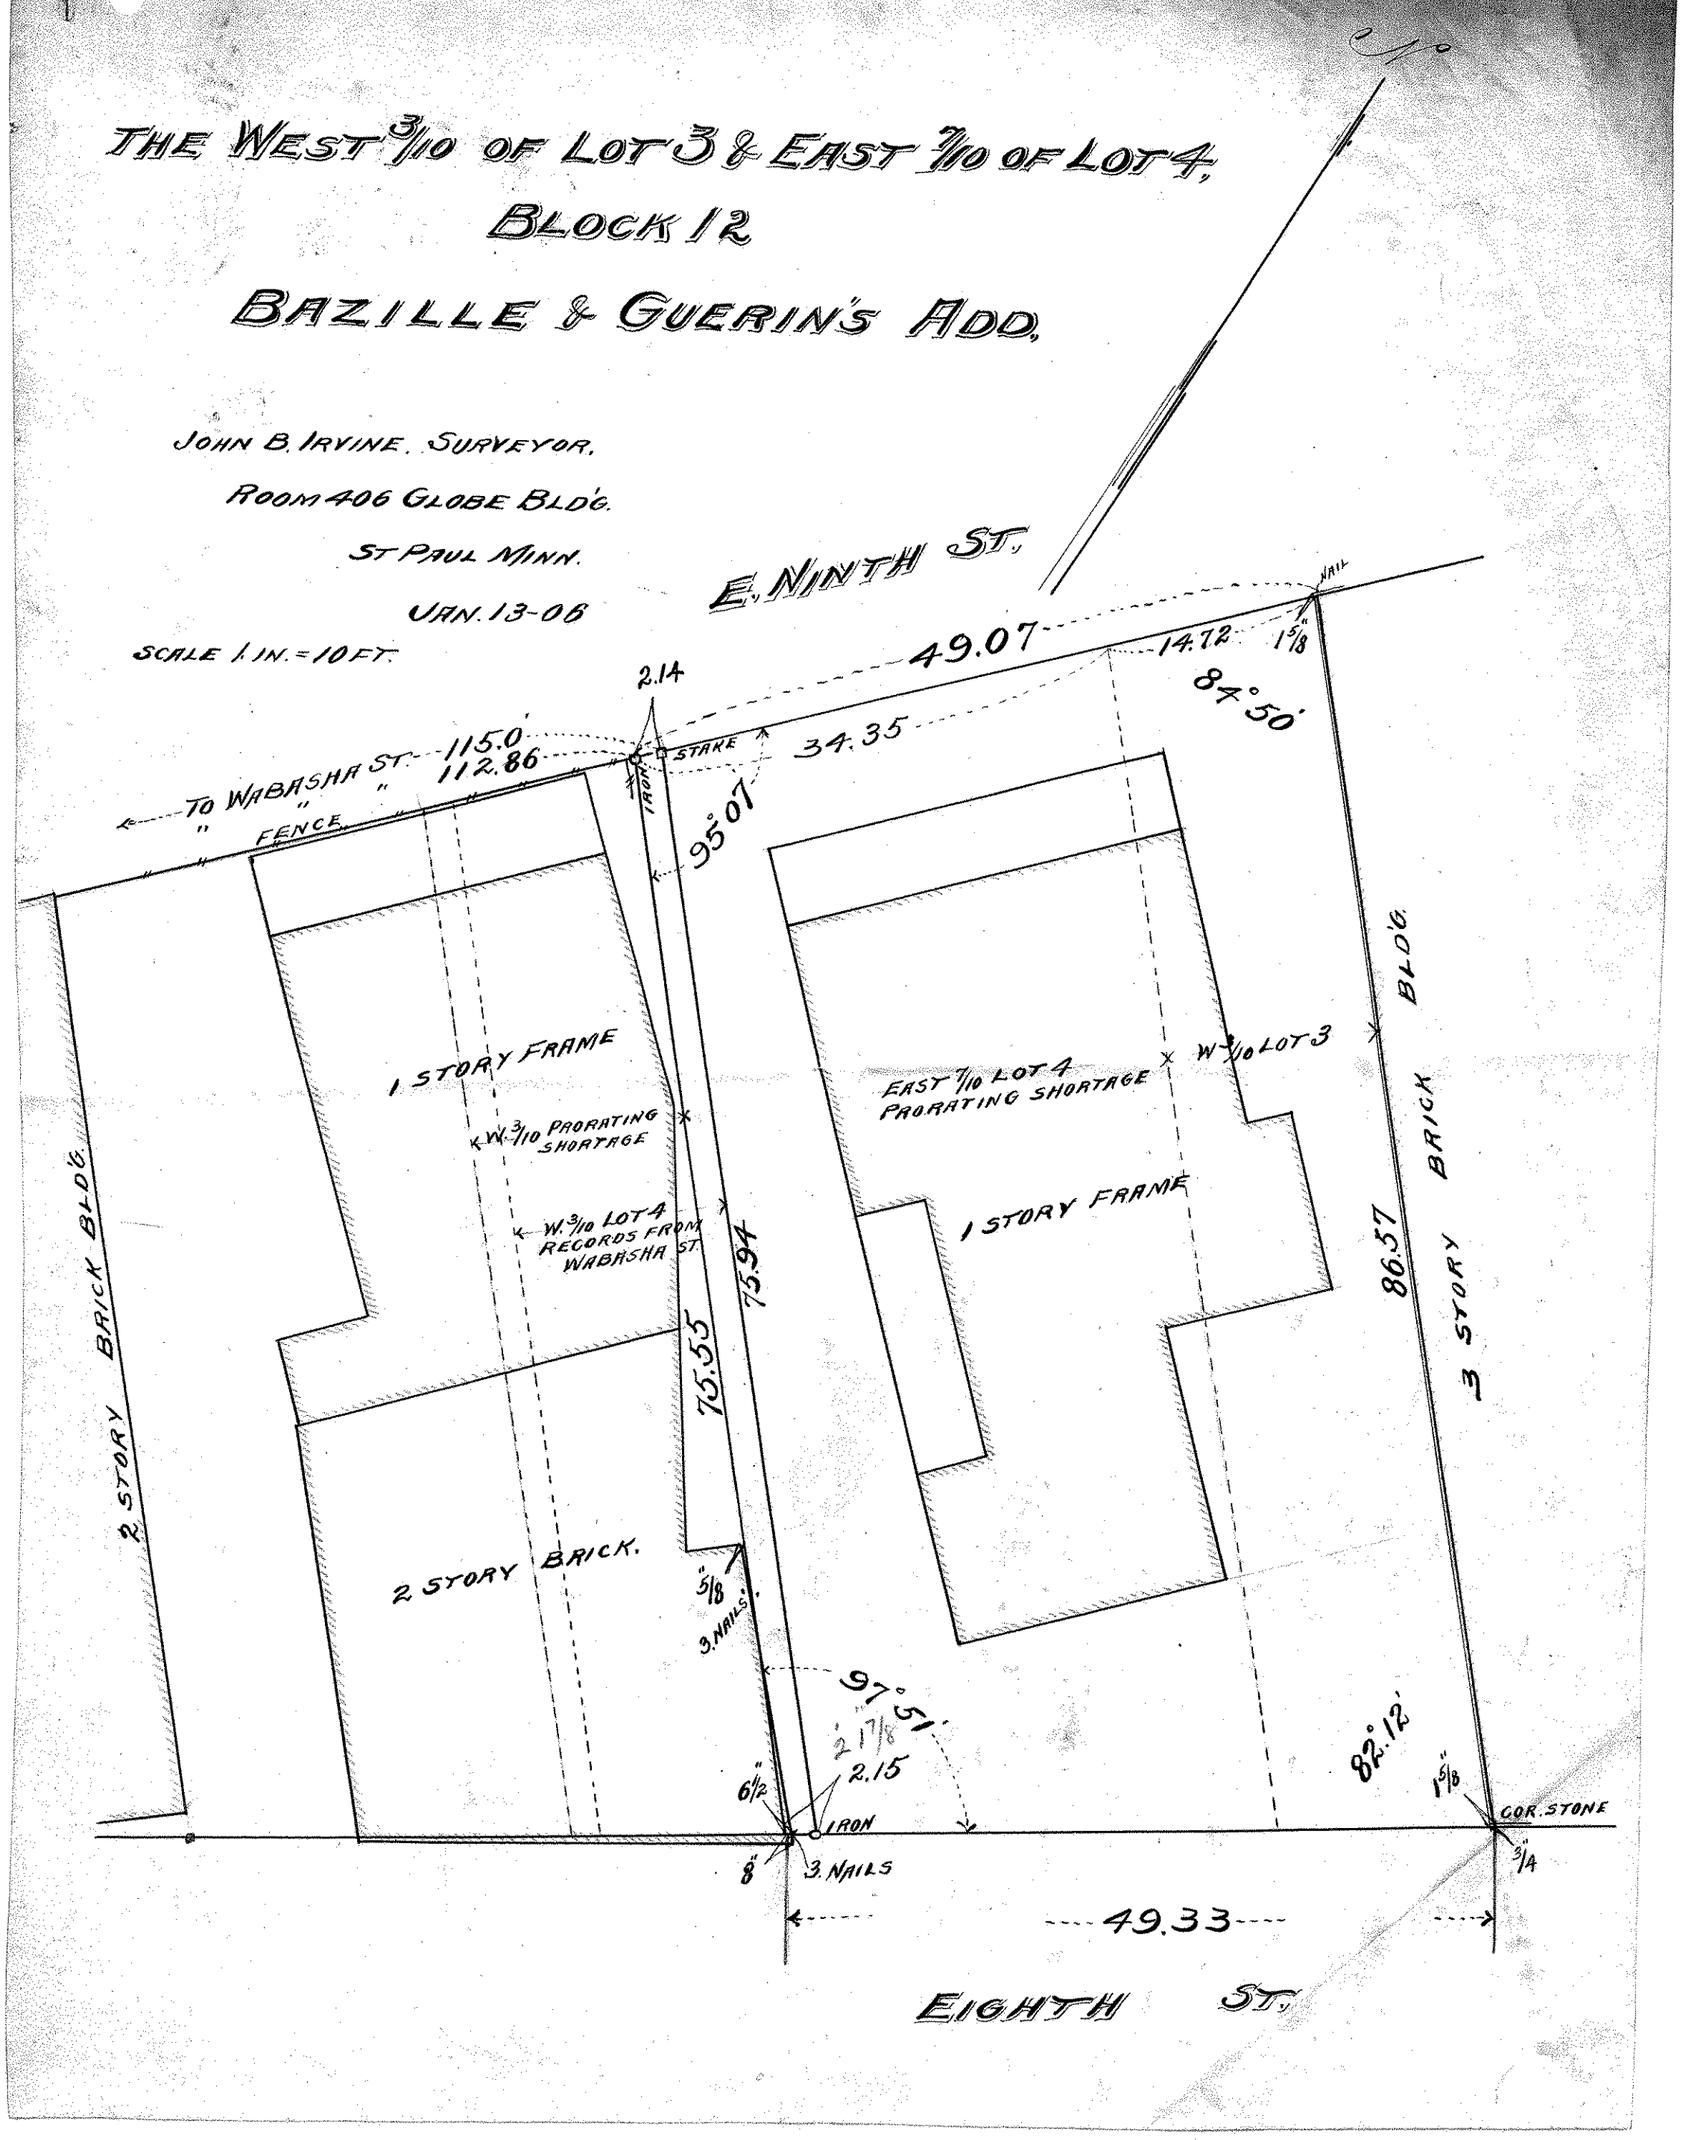
SCALE 1 IN. = 10 FT.