


W'LY. 66.41 FT. OF LOTS 13 & 14
BLK. 12 BAZILLE & GUERIN'S.

Scale 10 Feet pr. inch

Oct. 18'04 Dr. Kendrick.

Orpheum Music Hall

N

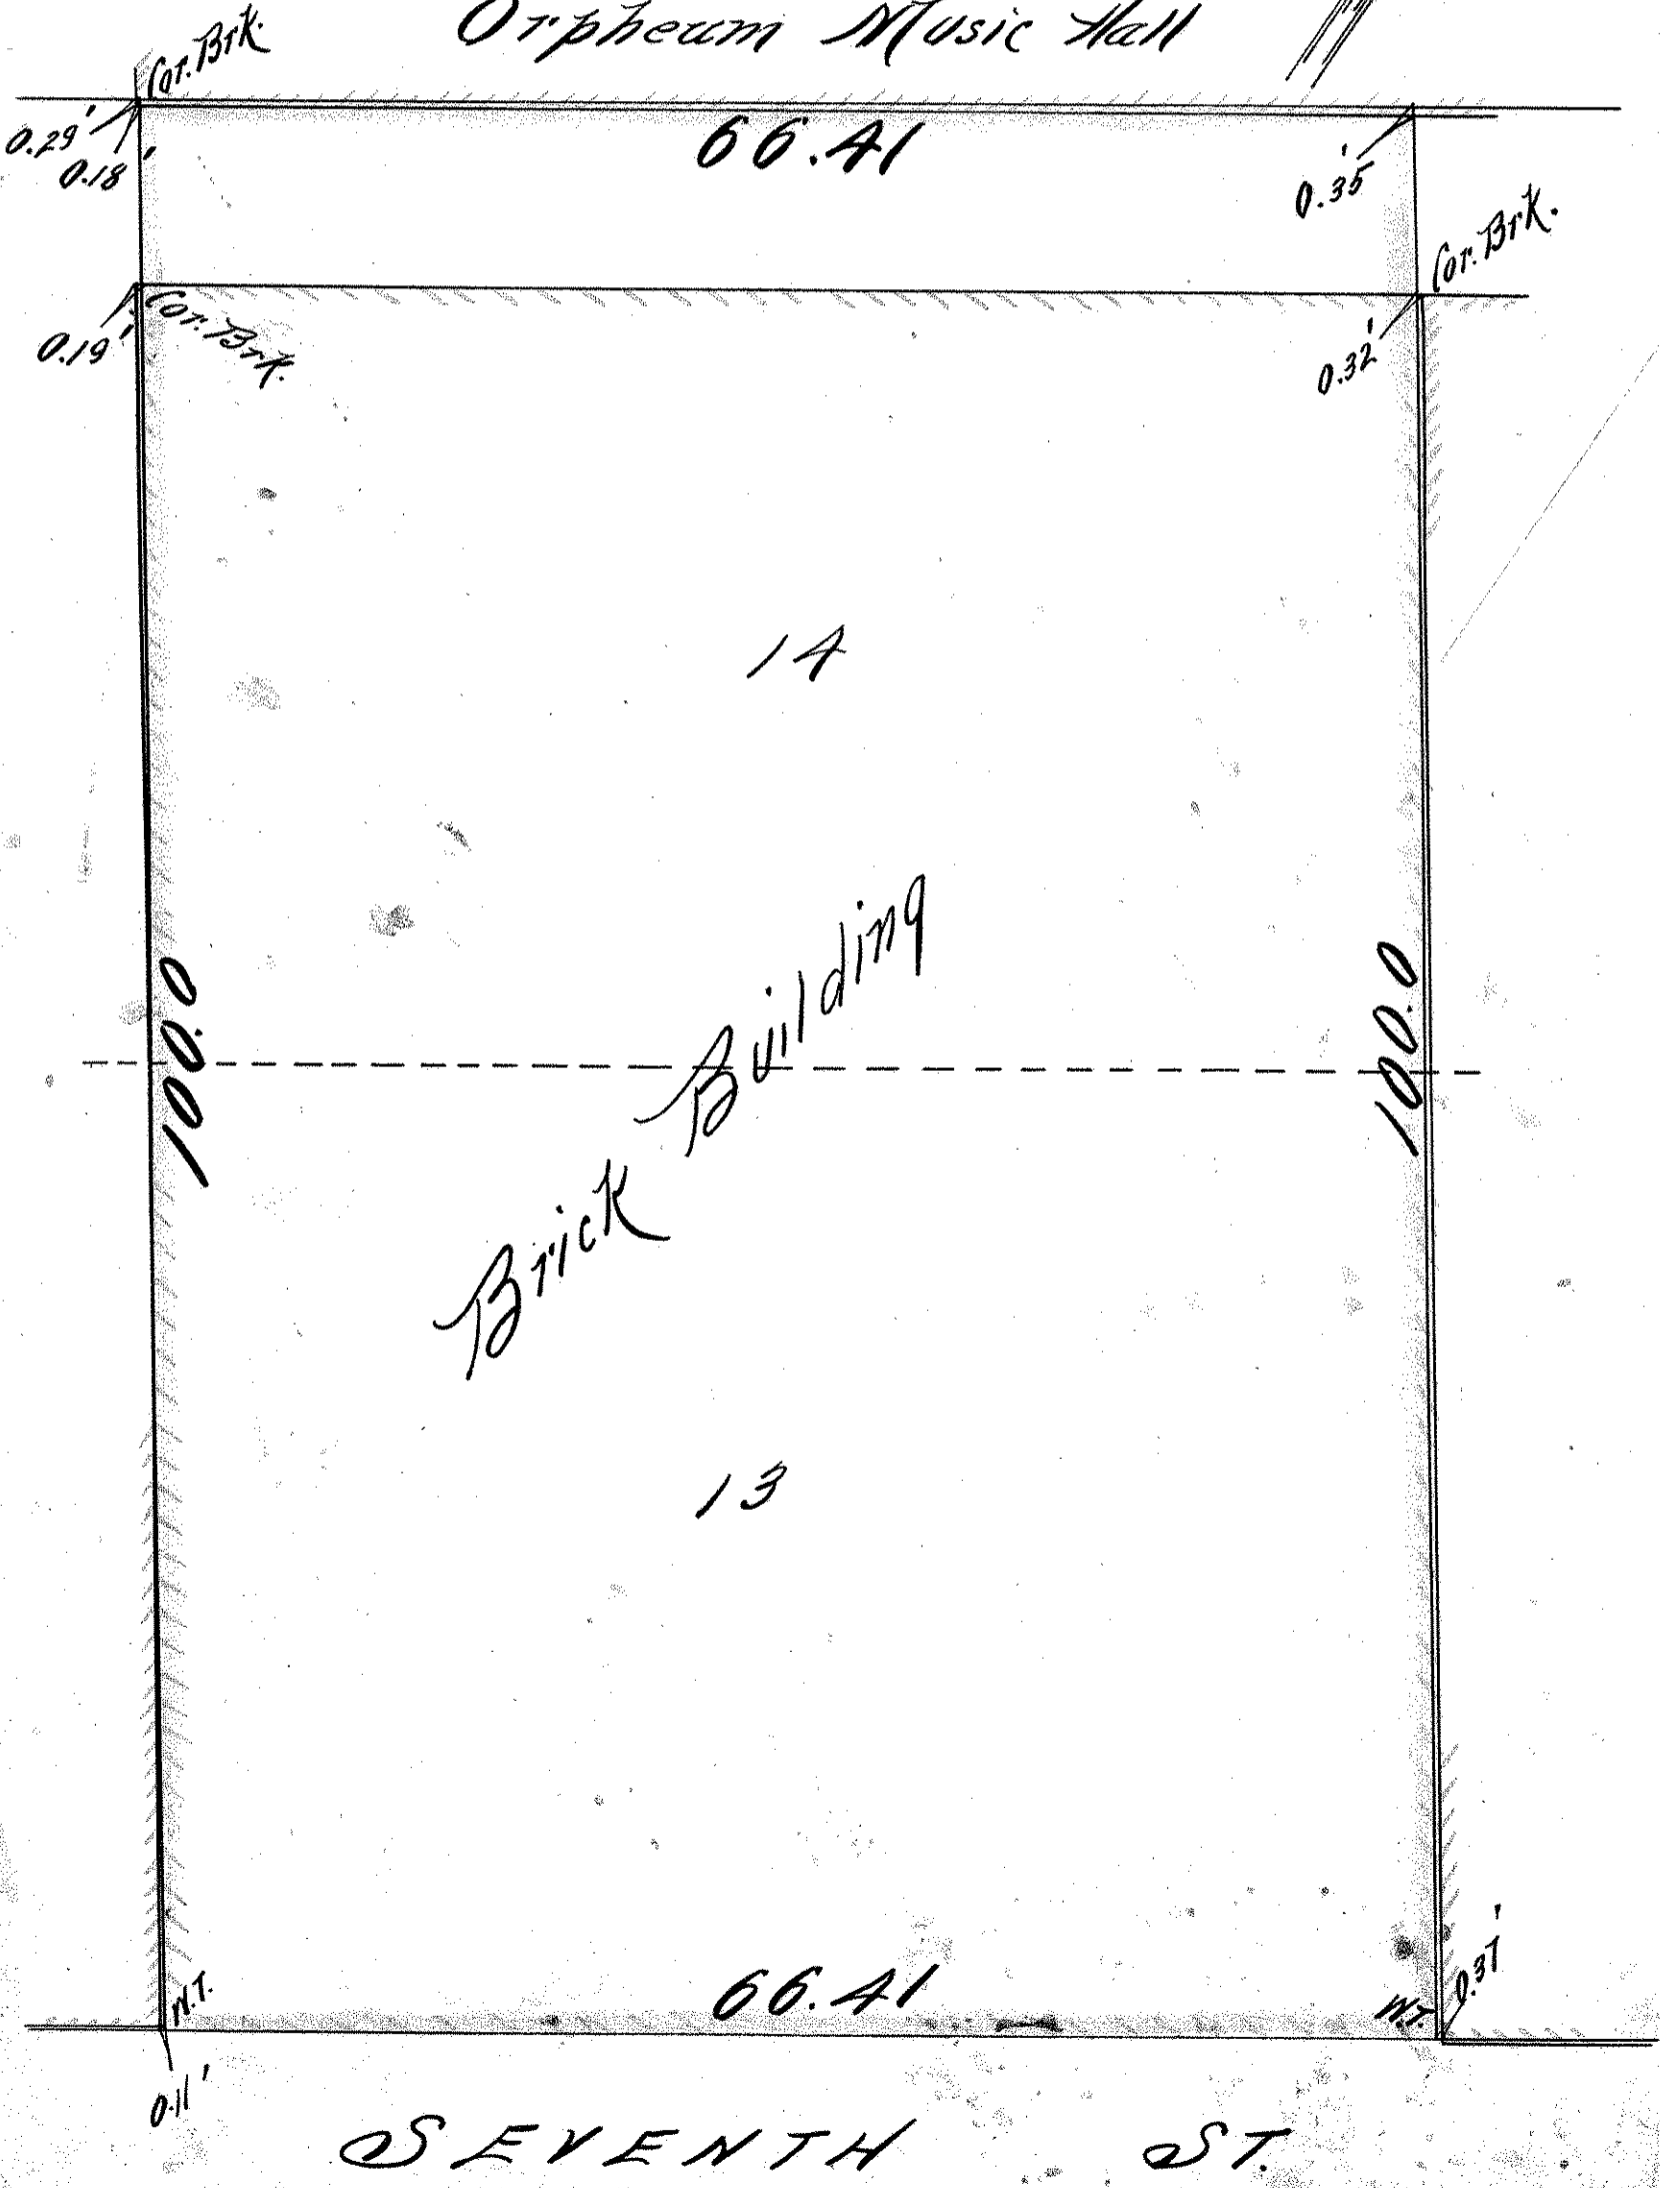

Brick Building

SEVENTH ST.