


SOUTH 1/2 LOT 3 BLOCK 10.
 BAZILLE & GUERIN'S ADD.
 John B. Irvine, Surveyor.
 March 2nd 1921.
 Scale 10ft. per. inch.

Figures underlined = elevations City datum.

4794
 272
 5013

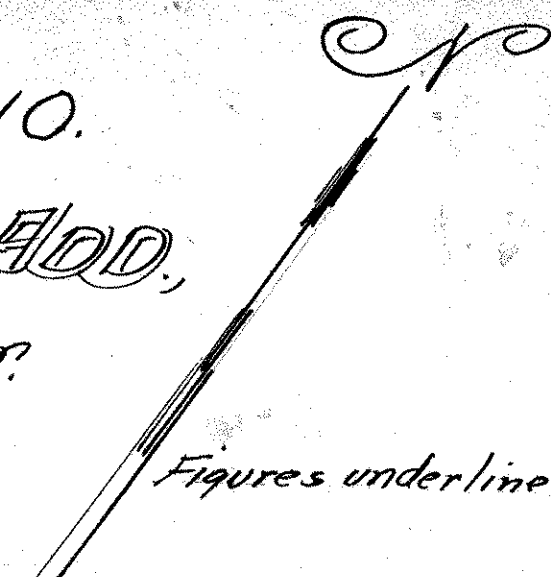

BRICK PAVED.

ALLEY

ST PETER ST

N. 1/2 LOT 3.

1 story brick
 face brick 3/8" so. of line 28.20

face brick 3/4" so. of line

4 story brick

9459 spike in header 33.63

142.31 This line 125 ft. so. of 9th St. Records

93.50
 cor. bill at 9/4" so. of line
 O.K. for St Peter St.

S. 1/2 LOT 3.

145 1/8 136.52 12 3/4

36.2 chimney
 1 story brick

60.1
 3 story brick - cor. brick 1"

9454 spike in header

25.70

40.2

25
 6 1/2

93.26

26