


MIDDLE 50. FT. OF LOT 11 BLK. 4
BAZILLE & GUERIN'S ADD.

10' = 1"

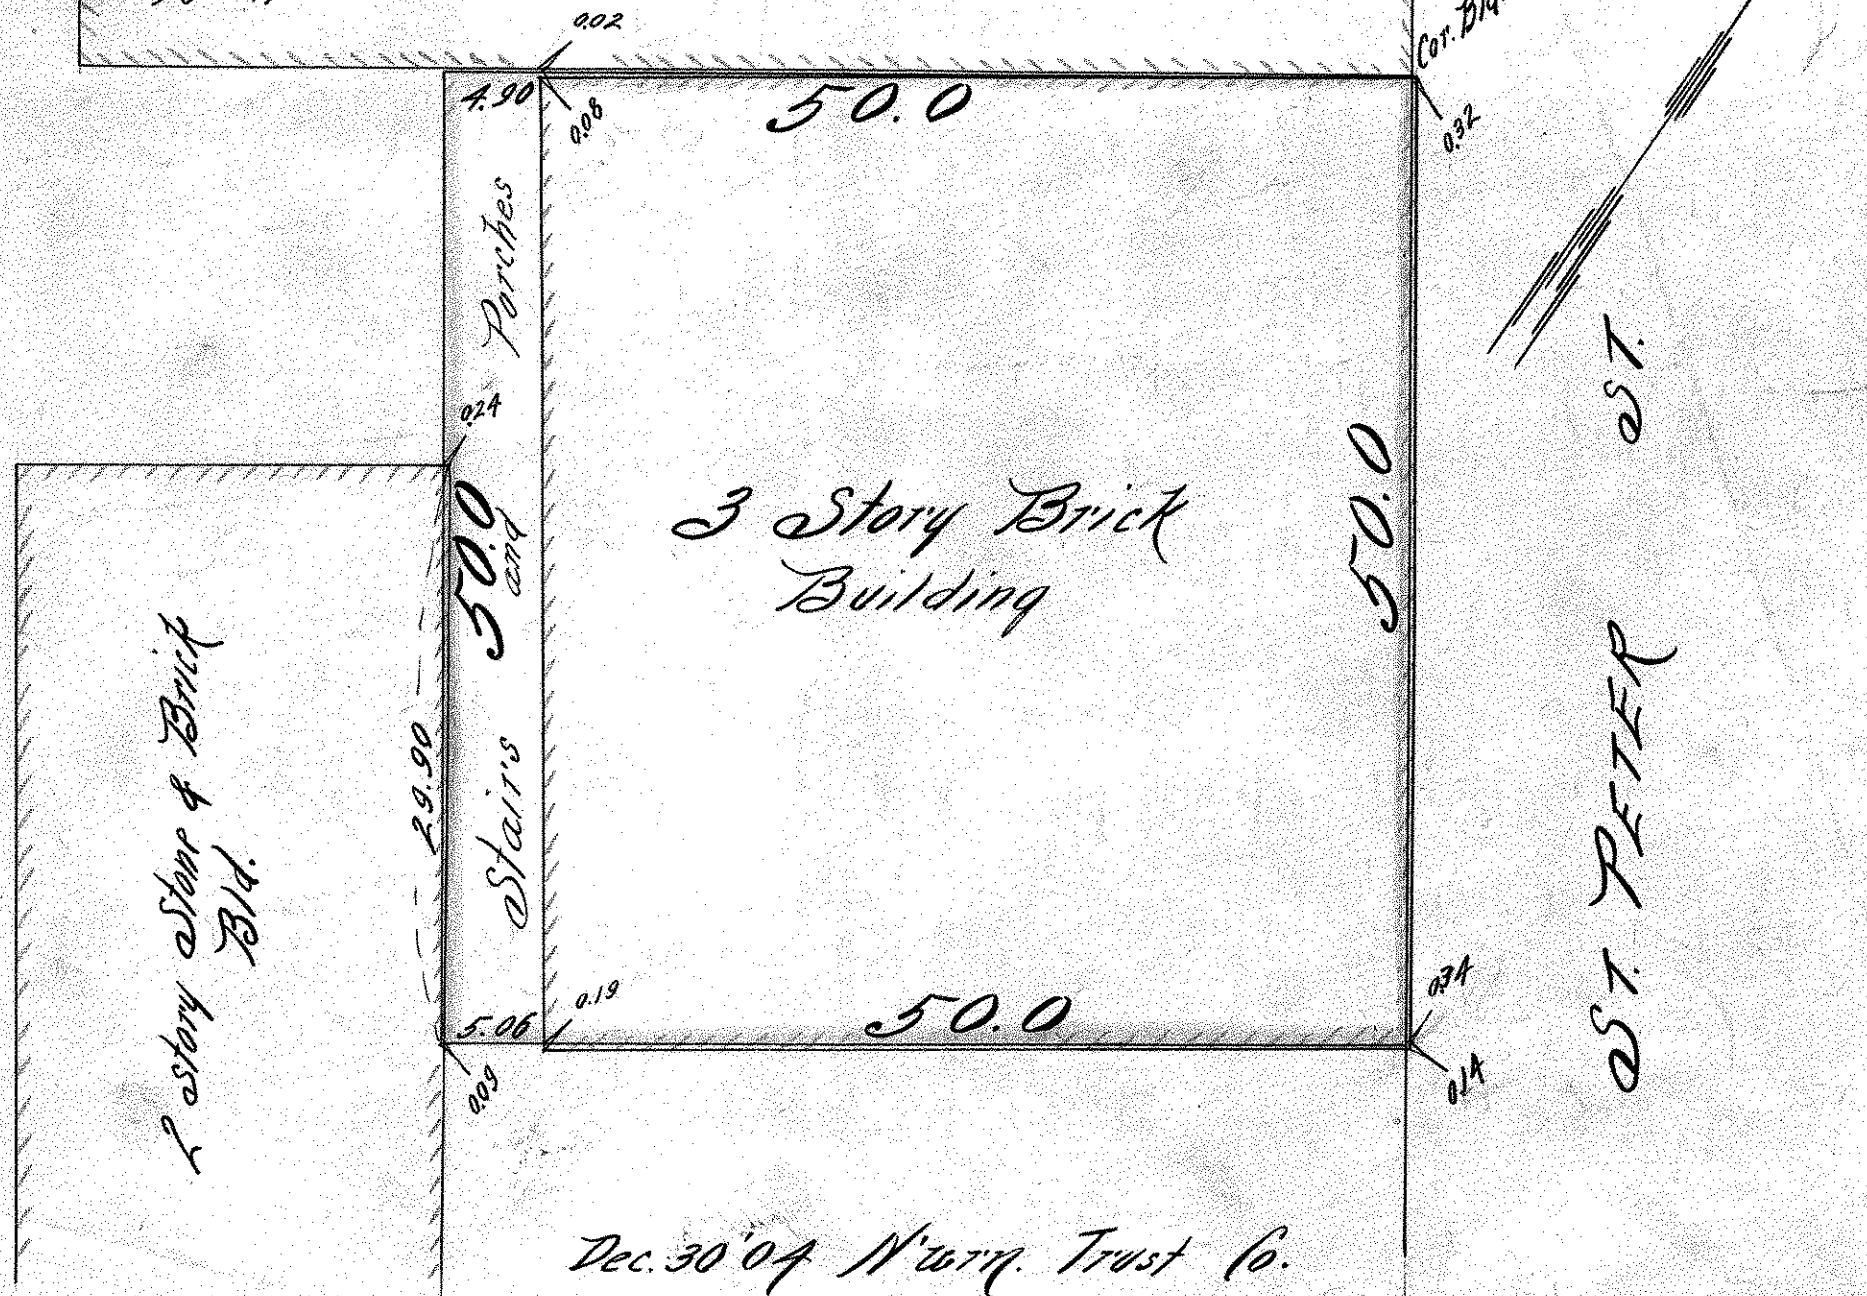

