3 STORY STONE B'LD'G.
ON LOT 1 BLK. 5 BAZILLE AND
GUERIN'S ADD. LOCATED FOR
T. W. Shepard Nov. 25th 1902
20 ft. pr. inch

N

TENTH ST.

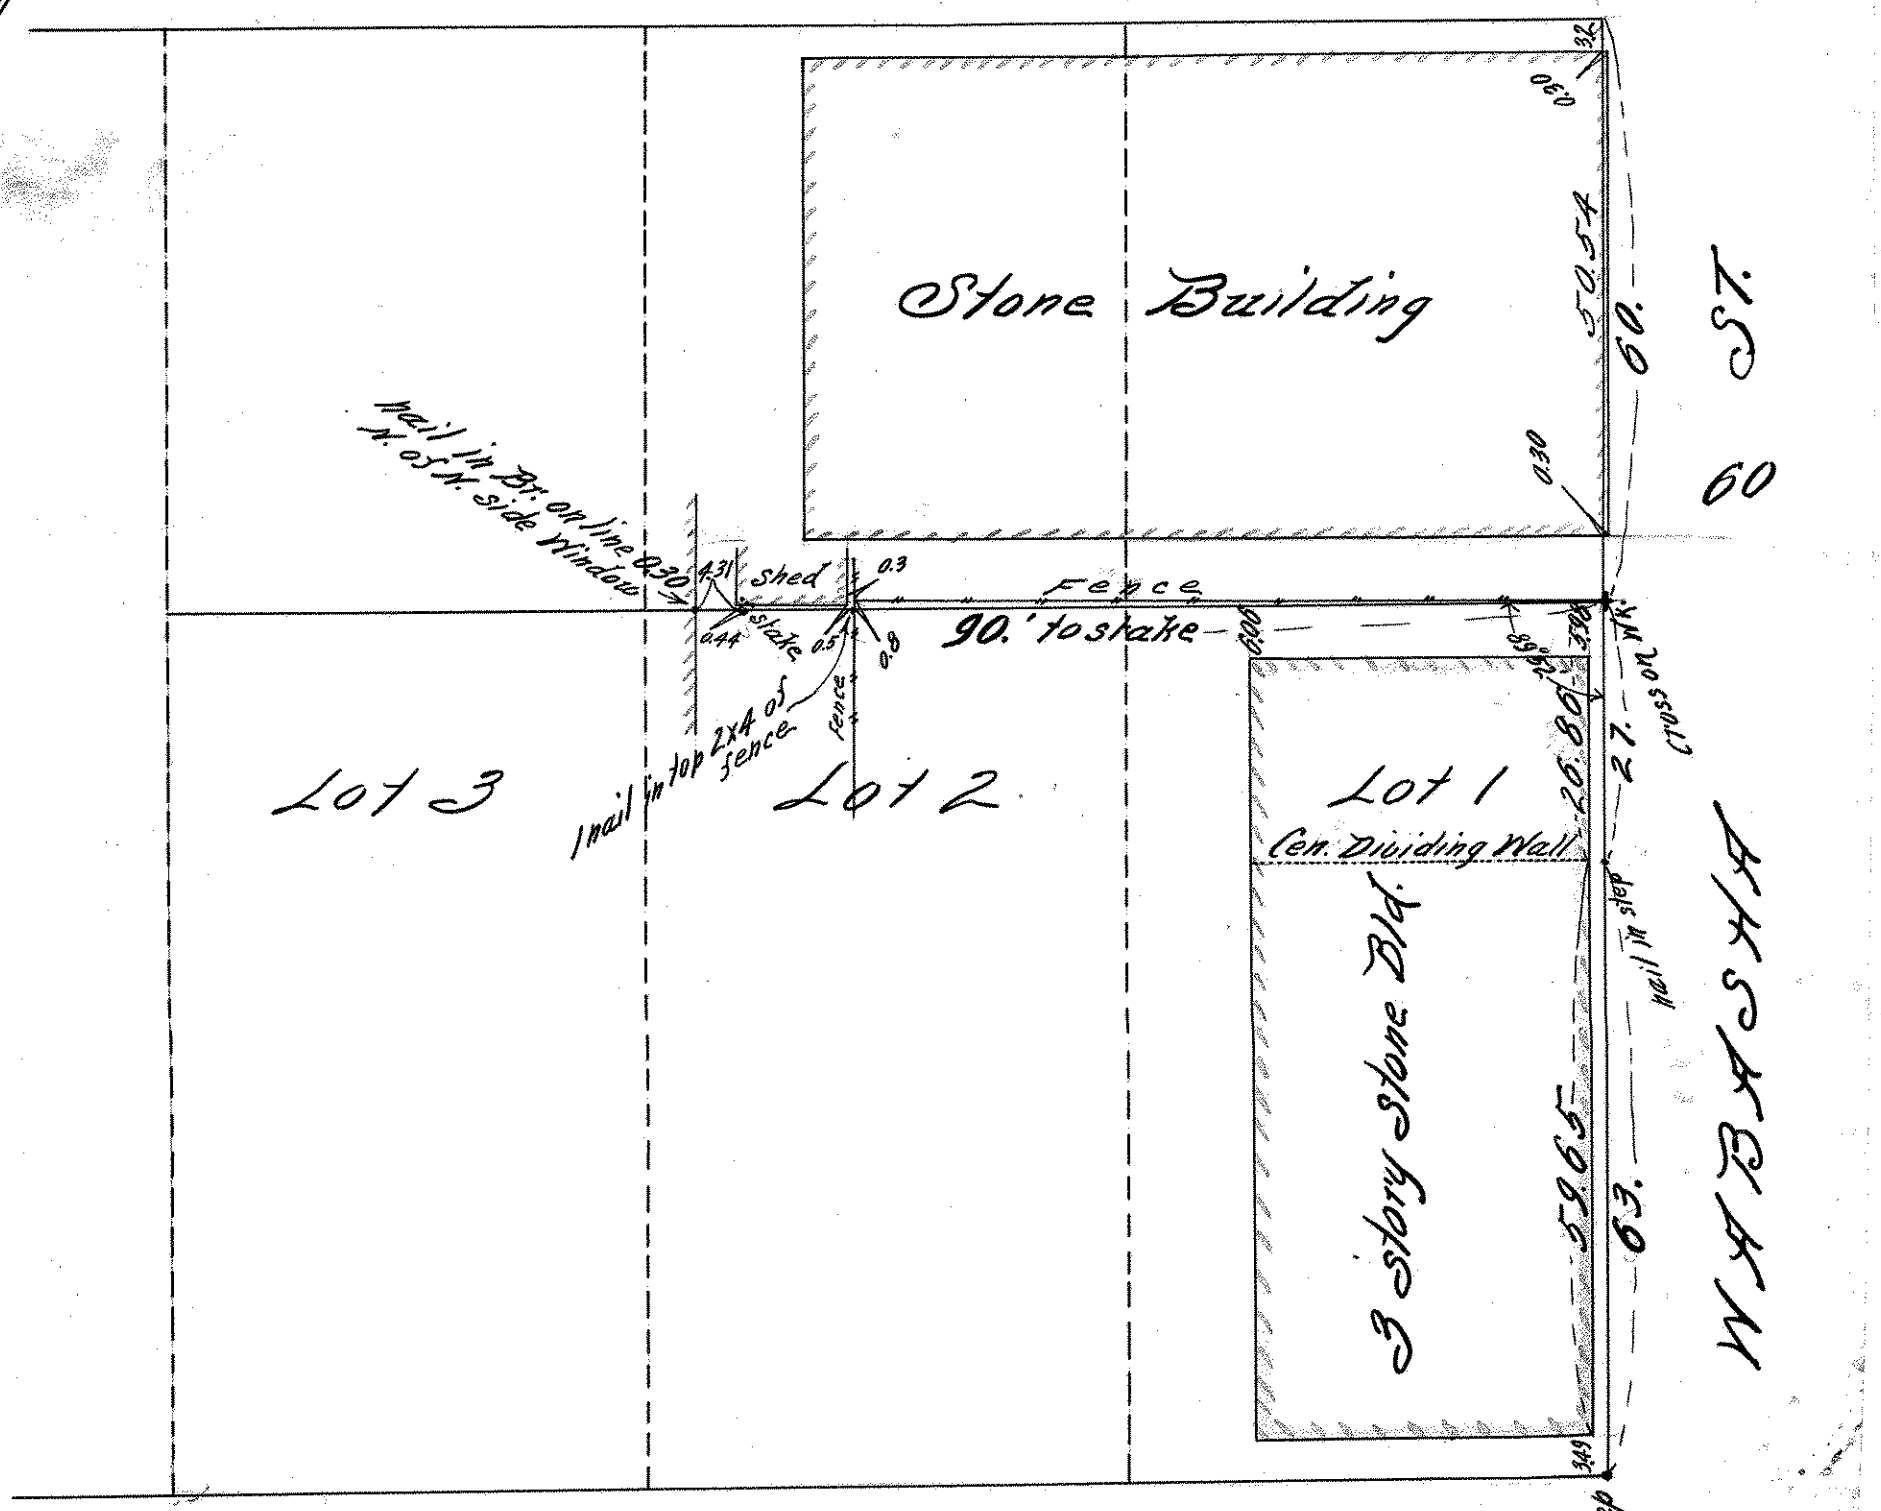

B. 53, P. 35.