LOTS 8 & 9 BLOCK 9.
EXCEPT THE SOUTHERLY 115 ft. and
EXCEPT THE NORTHERLY 3¼ inches
BAZIL & GUERIN'S ADD.

I hereby certify to having surveyed the above described property and located the buildings near or thereon as shown by this plat and the same is correct.

John B. Irvine Surveyor.
St. Paul, Minn
May 4th 1917
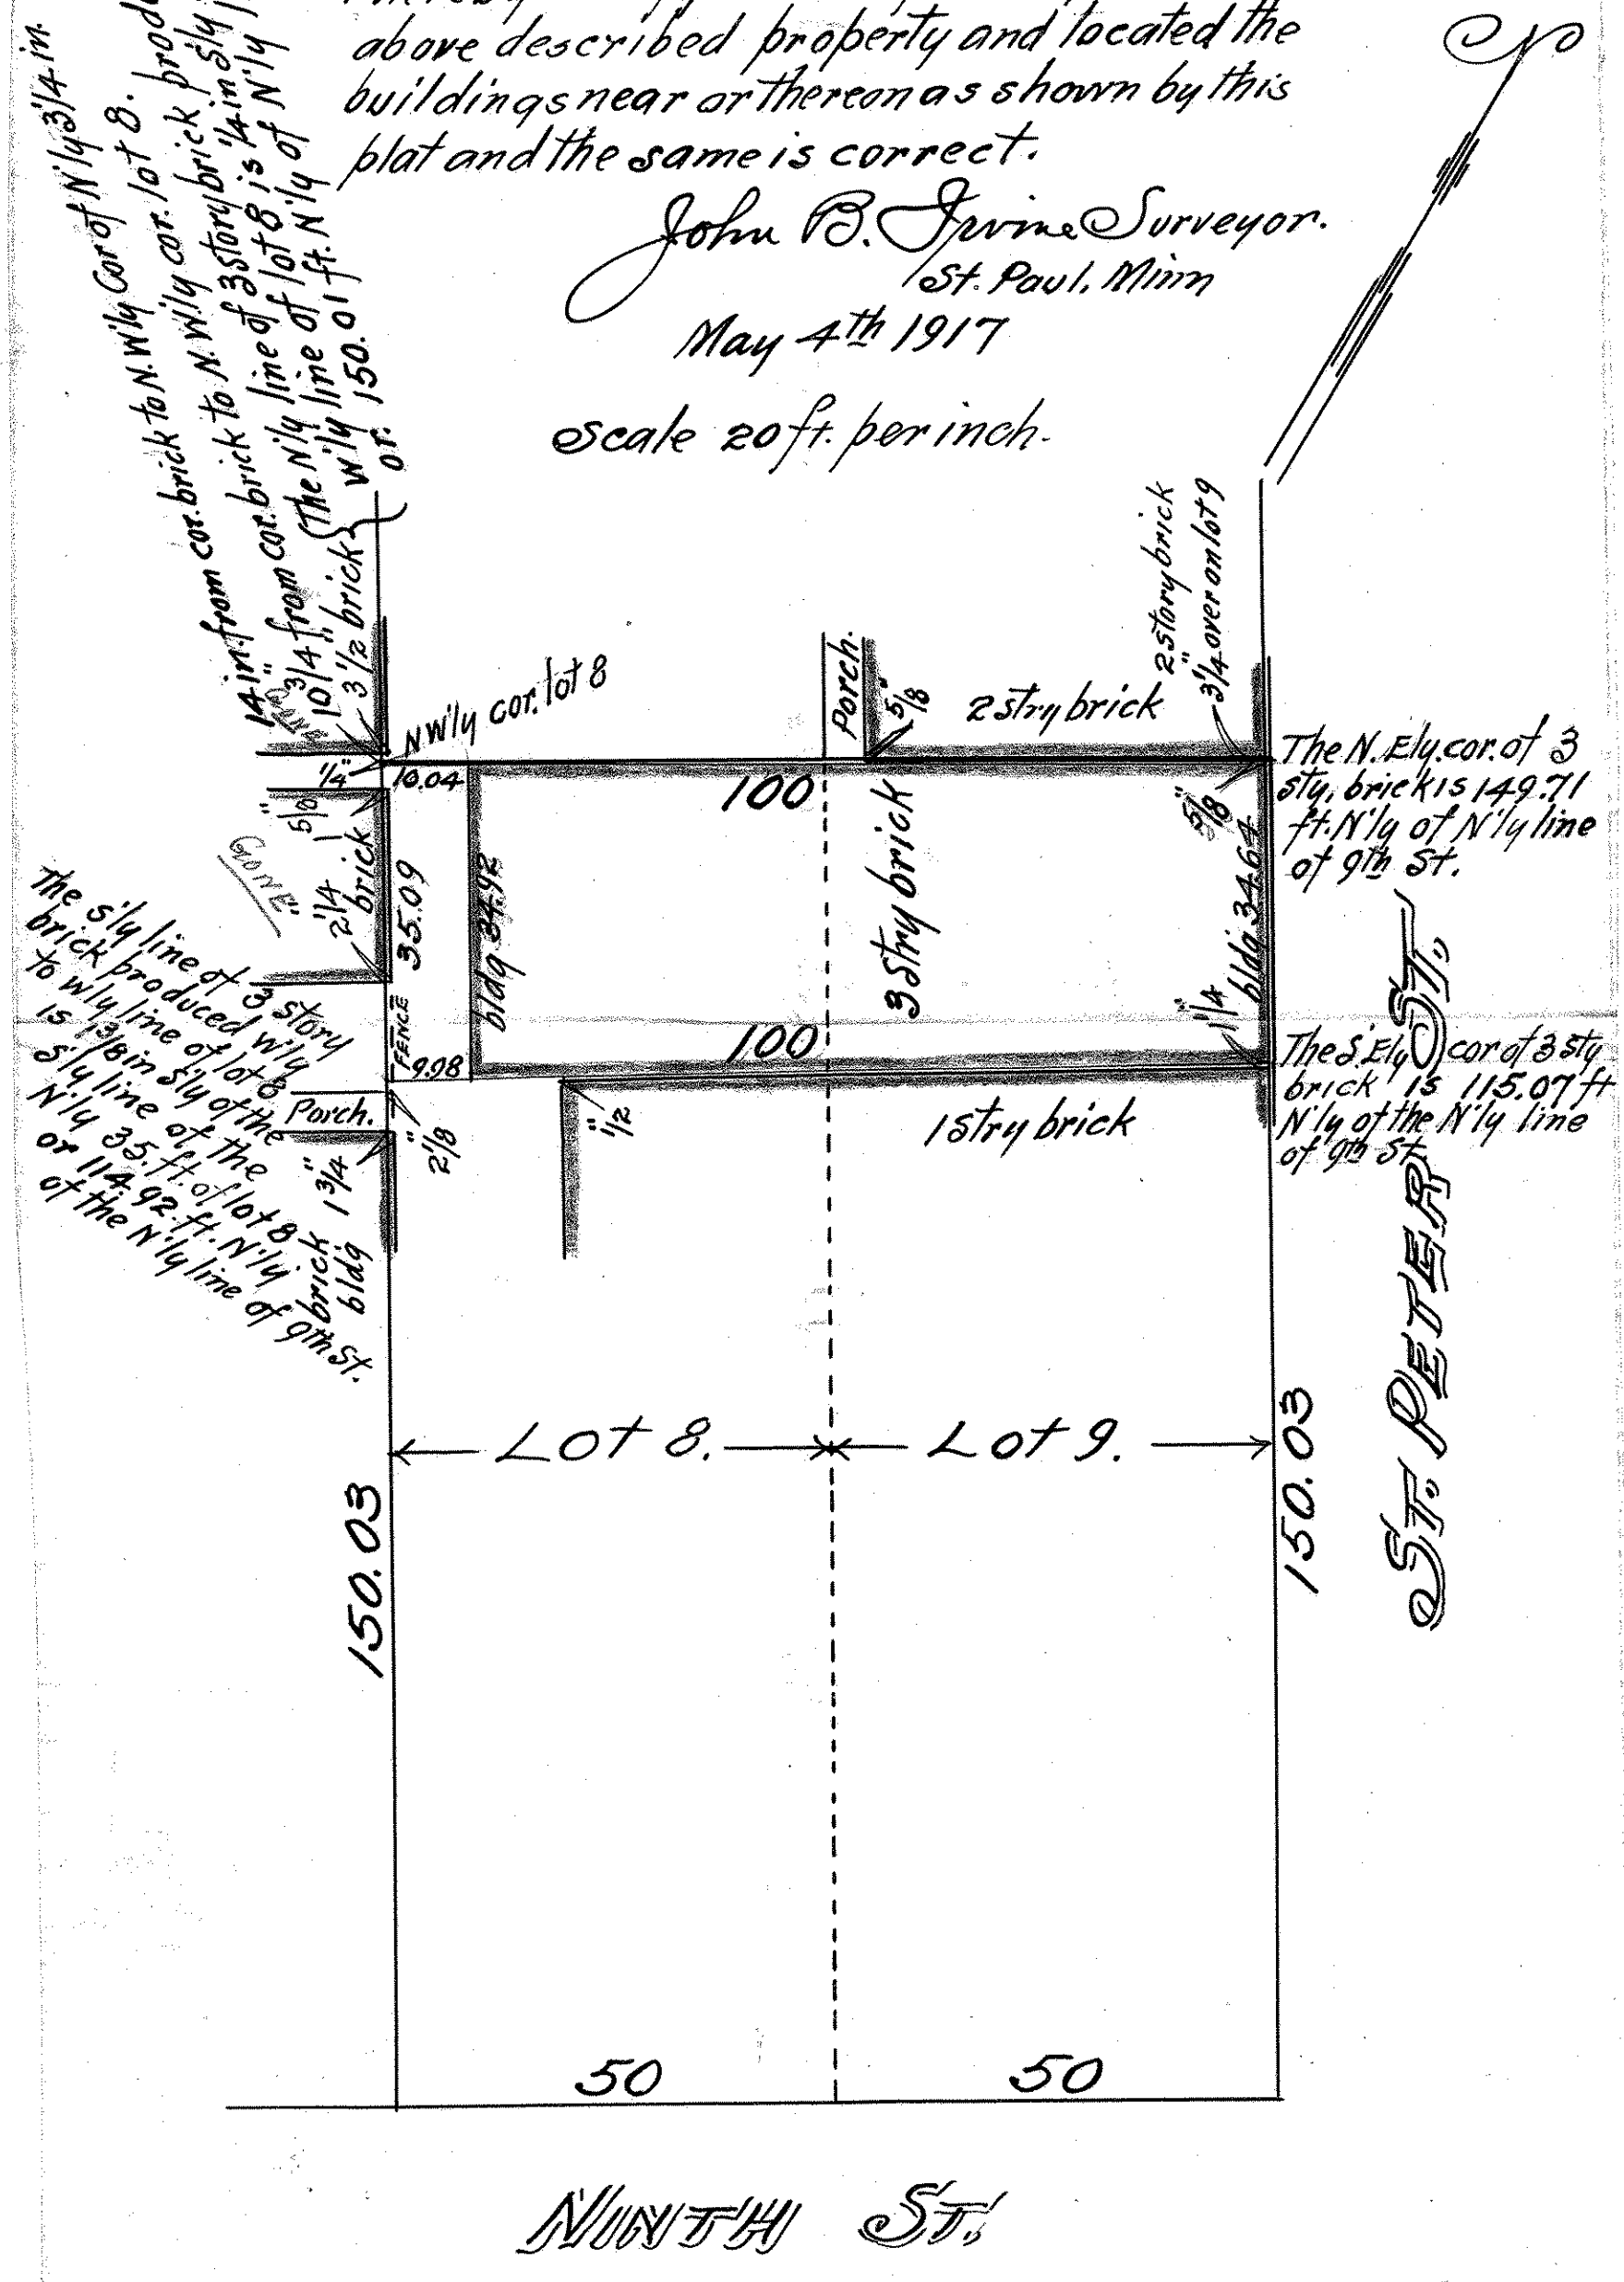
Scale 20 ft. per inch.