

SW 29-22

GOMSTOCK AND DAVIS INC.

3092 N. LEXINGTON AVE. ST. PAUL, MN. 55113 483-4408

SURVEYED FOR: Bernard Andert


DESCRIPTION: Lot 7 and the East 1/2 of Lot 8, Block 6, Wifelburg Hills, Ramsey County, Minnesota.

WEST ORANGE AVENUE



IF • Denotes Iron Pipe Found
○ Denotes Iron Pipe set and marked with Reg. No. 10459.
Easements as per plat only are shown.

SCALE: 1" = 30'

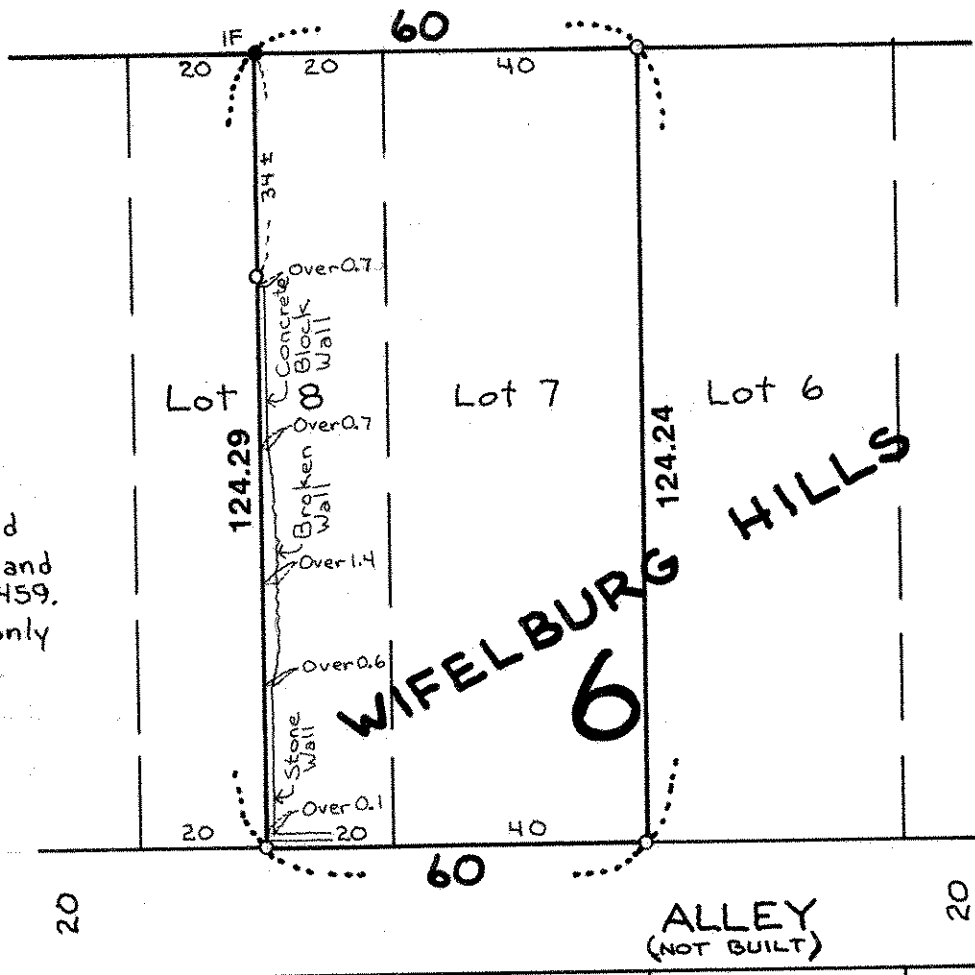

I hereby certify that this survey, plan plat, preliminary plat or report was prepared by me or under my direct supervision and that I am a duly Registered Land Surveyor under the laws of the State of Minnesota.

Donald Schmidt

10459
Reg. No.

5/12/92
Date

R-92794
Job No.

Book No.