


GOMSTOCK AND DAVIS INC.

3092 N. LEXINGTON AVE. ST. PAUL, MN. 55113 483-4408

A SURVEY FOR RADA POPOV SEE SHEET 2 FOR DESCRIPTION

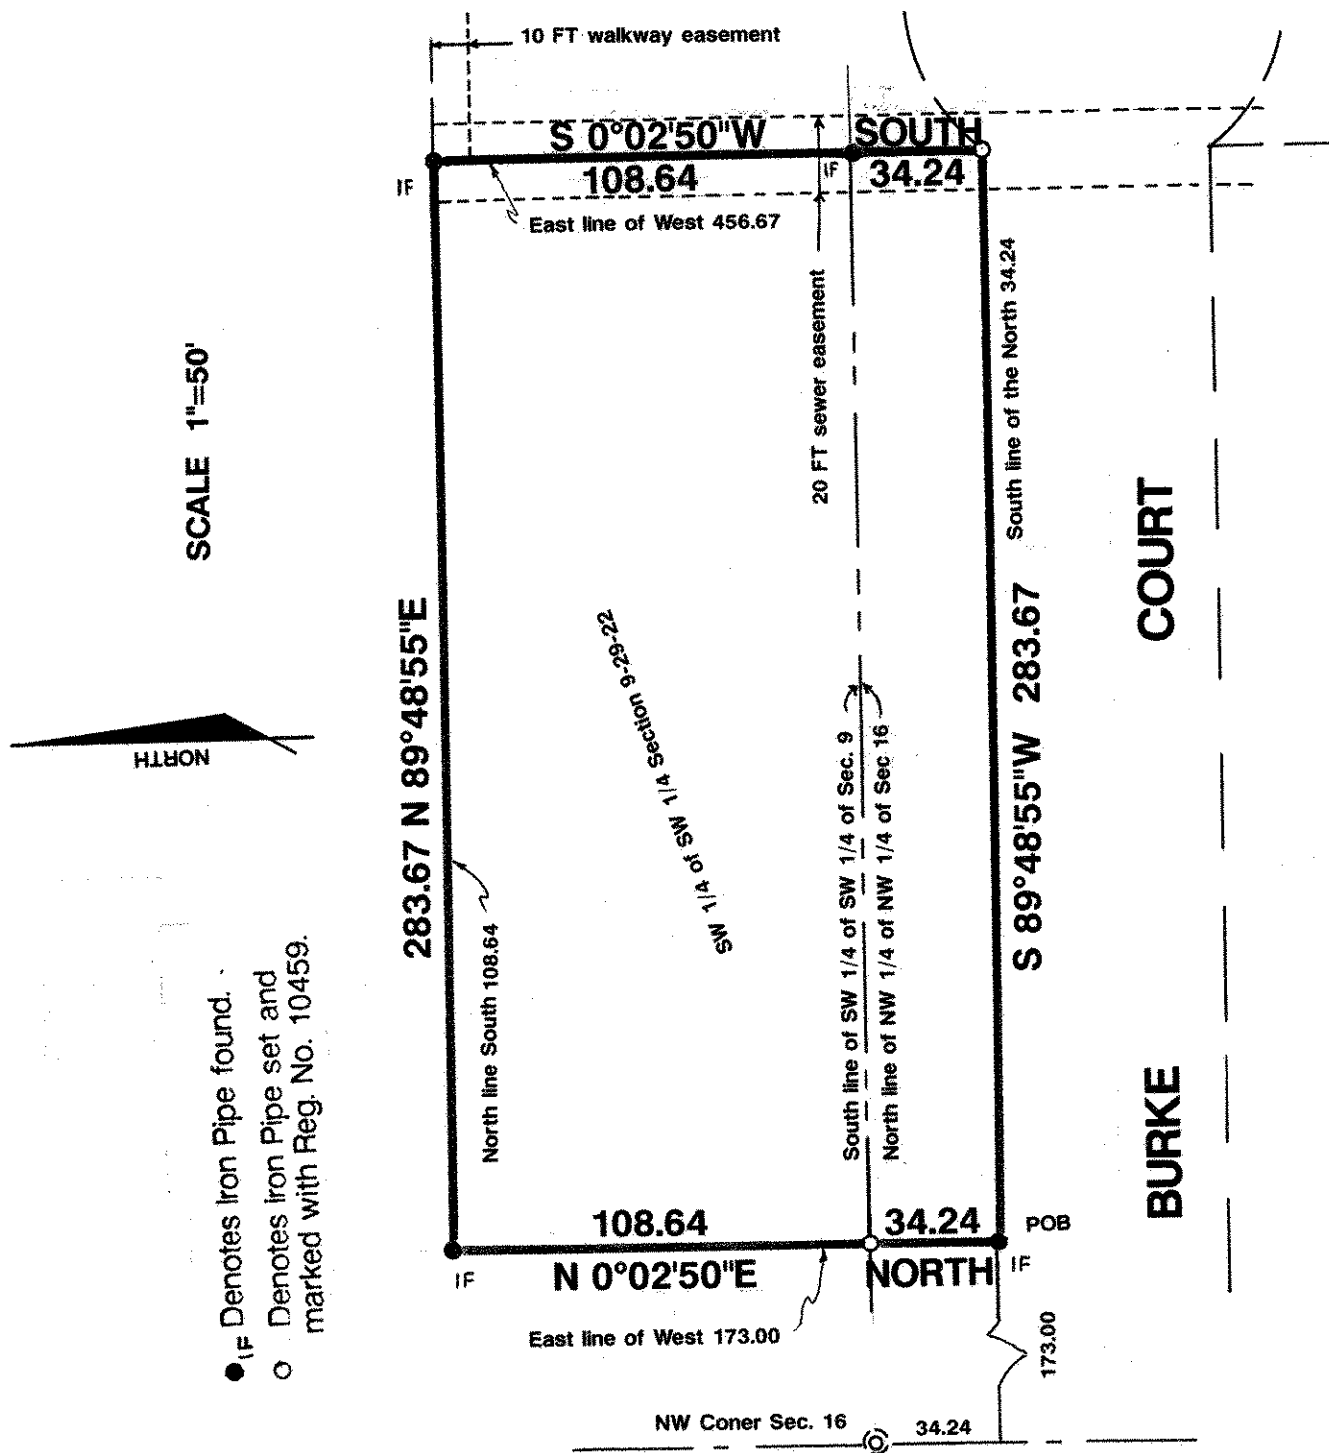

- IF Denotes Iron Pipe found.
- Denotes Iron Pipe set and marked with Reg. No. 10459.

I hereby certify that this survey, plan plat, preliminary plat or report was prepared by me or under my direct supervision and that I am a duly Registered Land Surveyor under the laws of the State of Minnesota.

Douglas W. Schmed 10459 9/14/92 R-92852 SHEET 1 OF 2
 Reg. No. Date Job No. Book No.