NW 6, 29, 22

FROM THE OFFICE OF

CHARLES O. GEORGI COMPANY

2215 West County Road B Saint Paul, Minnesota 55113

REGISTERED CIVIL ENGINEER AND LAND SURVEYOR

Certificate of Survey

I Hereby Certify that this plat shows a survey made by me of the property described on this plat, and that the corners are correctly placed as shown, and that all locations have been correctly shown. * 3/22/66 moved West line 50' East.

Surveyed For Empire Steel Inc.

Date March 1966

Scale 1" = 100'

By Charles O. Georgi
REGISTERED LAND SURVEYOR

Description:
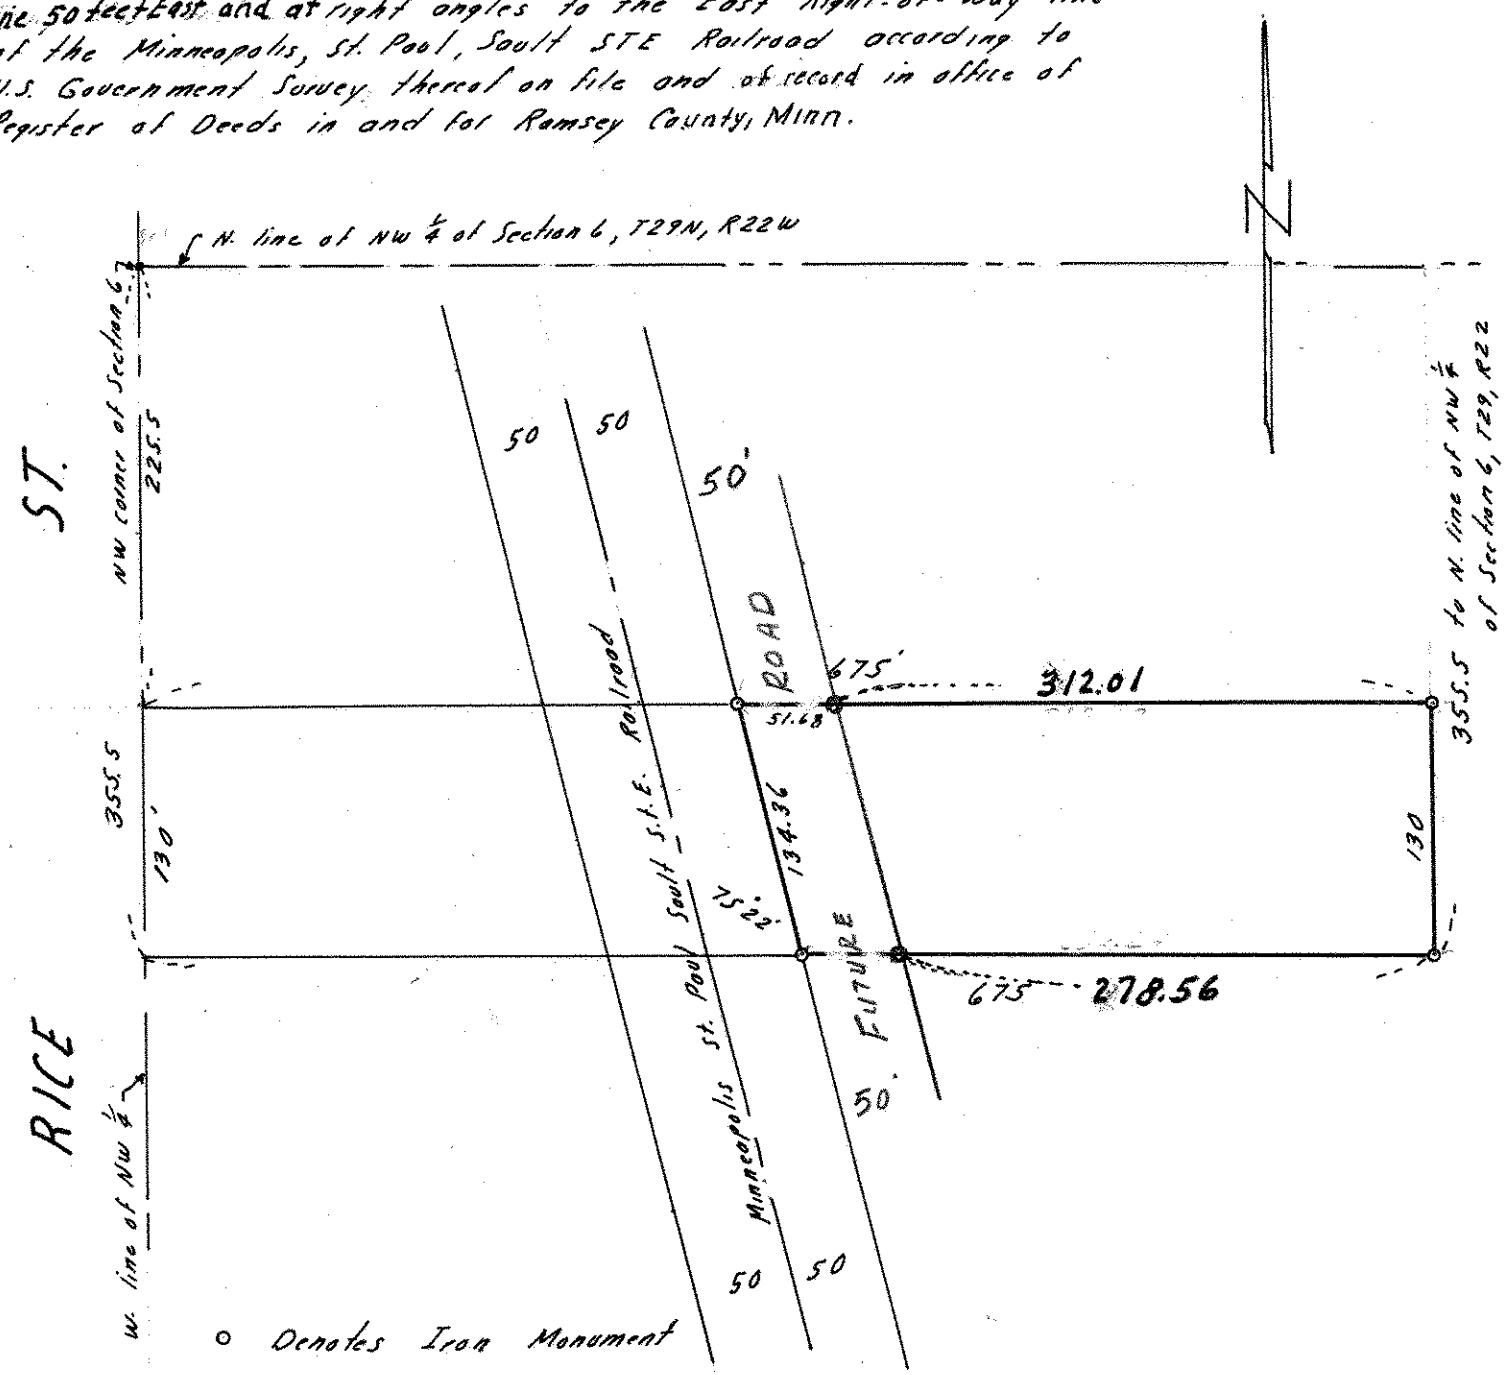
The South 130 feet of the North 355.5 feet of the West 675 feet of that part of the NW ¼ of the NW ¼ of Section 6, T29N, R22W lying East of line 50 feet East and at right angles to the East Right-of-Way line of the Minneapolis, St. Paul, Sault STE Railroad according to U.S. Government Survey thereof on file and of record in office of Register of Deeds in and for Ramsey County, Minn.