

GOMSTOCK AND DAVIS INC.

3092 N. LEXINGTON AVE. ST. PAUL, MN. 55113 483-4408

SURVEYED FOR: Frank Frattalone

Description: Lot 13, Block 1, Kohlman Lake Overlook, Ramsey County, Minnesota




IF ● Denotes Iron Pipe Monument found from previous surveys.

○ Denotes Iron Pipe Monument set and marked 10459.

Platted Easements only are shown.

SCALE: 1" = 40'

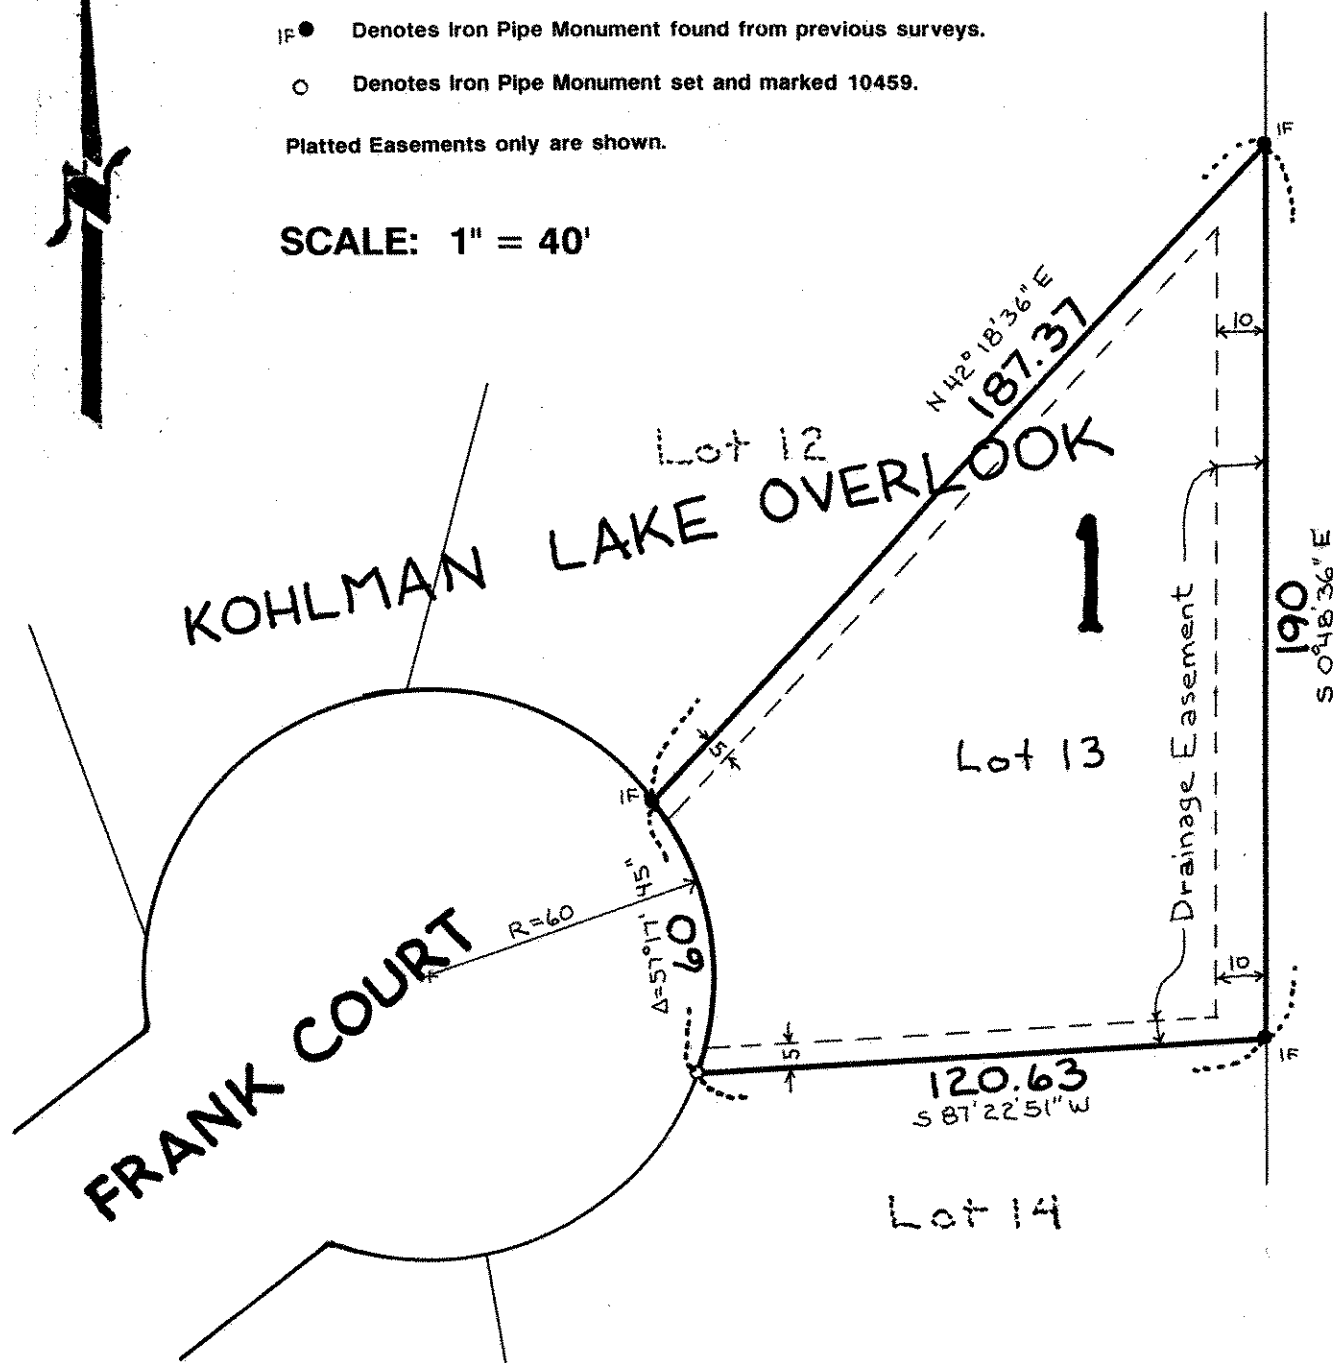

I hereby certify that this survey, plan plat, preliminary plat or report was prepared by me or under my direct supervision and that I am a duly Registered Land Surveyor under the laws of the State of Minnesota.

Donald W. Schmed

10459
Reg. No.

6/24/93
Date

931319
Job No.

Book No.