COMSTOCK AND DAVIS INC.

3092 NORTH LEXINGTON AVE., ST. PAUL, MN 55113 (612) 483-4408

SURVEYED FOR: FRANK FRATTALONE


of Minnesota.

Donald W. Schmidt

10459

Reg. No.

DESCRIPTION: Lot 16, Block 3, Kohlman Lake Overlook No. 2, Ramsey County, Minnesota.

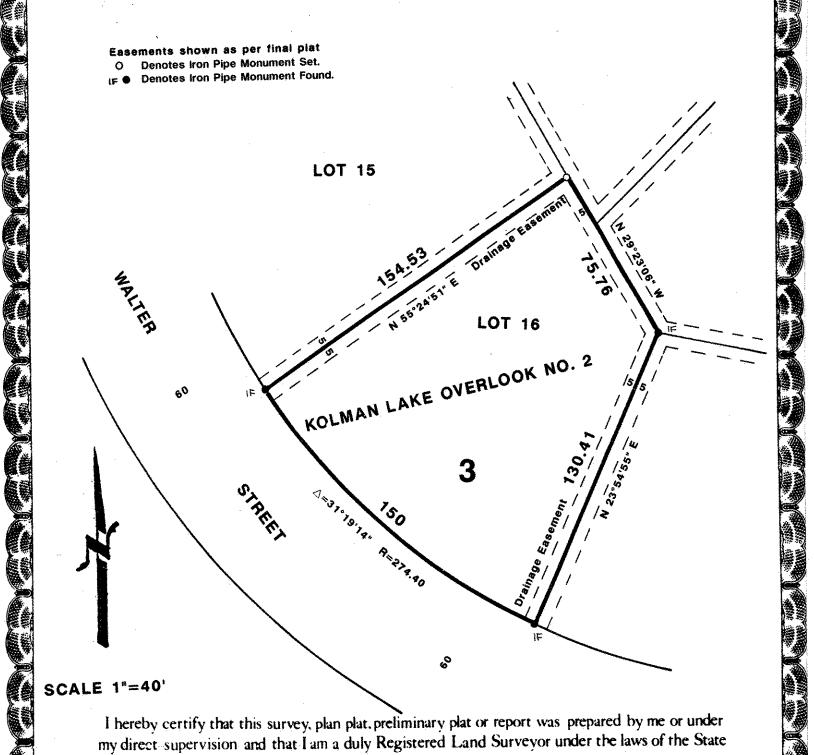

Book No.

Job No.