


# GOMSTOCK AND DAVIS INC.

3092 N. LEXINGTON AVE. ST. PAUL, MN. 55113 483-4408

SURVEYED FOR: FRANK FRATTALONE

DESCRIPTION: Lot 17, Block 3, Kohlman Lake Overlook No. 2, Ramsey County, Minnesota.

○ Denotes Iron Pipe Monument Set.  
IF ● Denotes Iron Pipe Monument Found.  
Easements shown as per final plat.

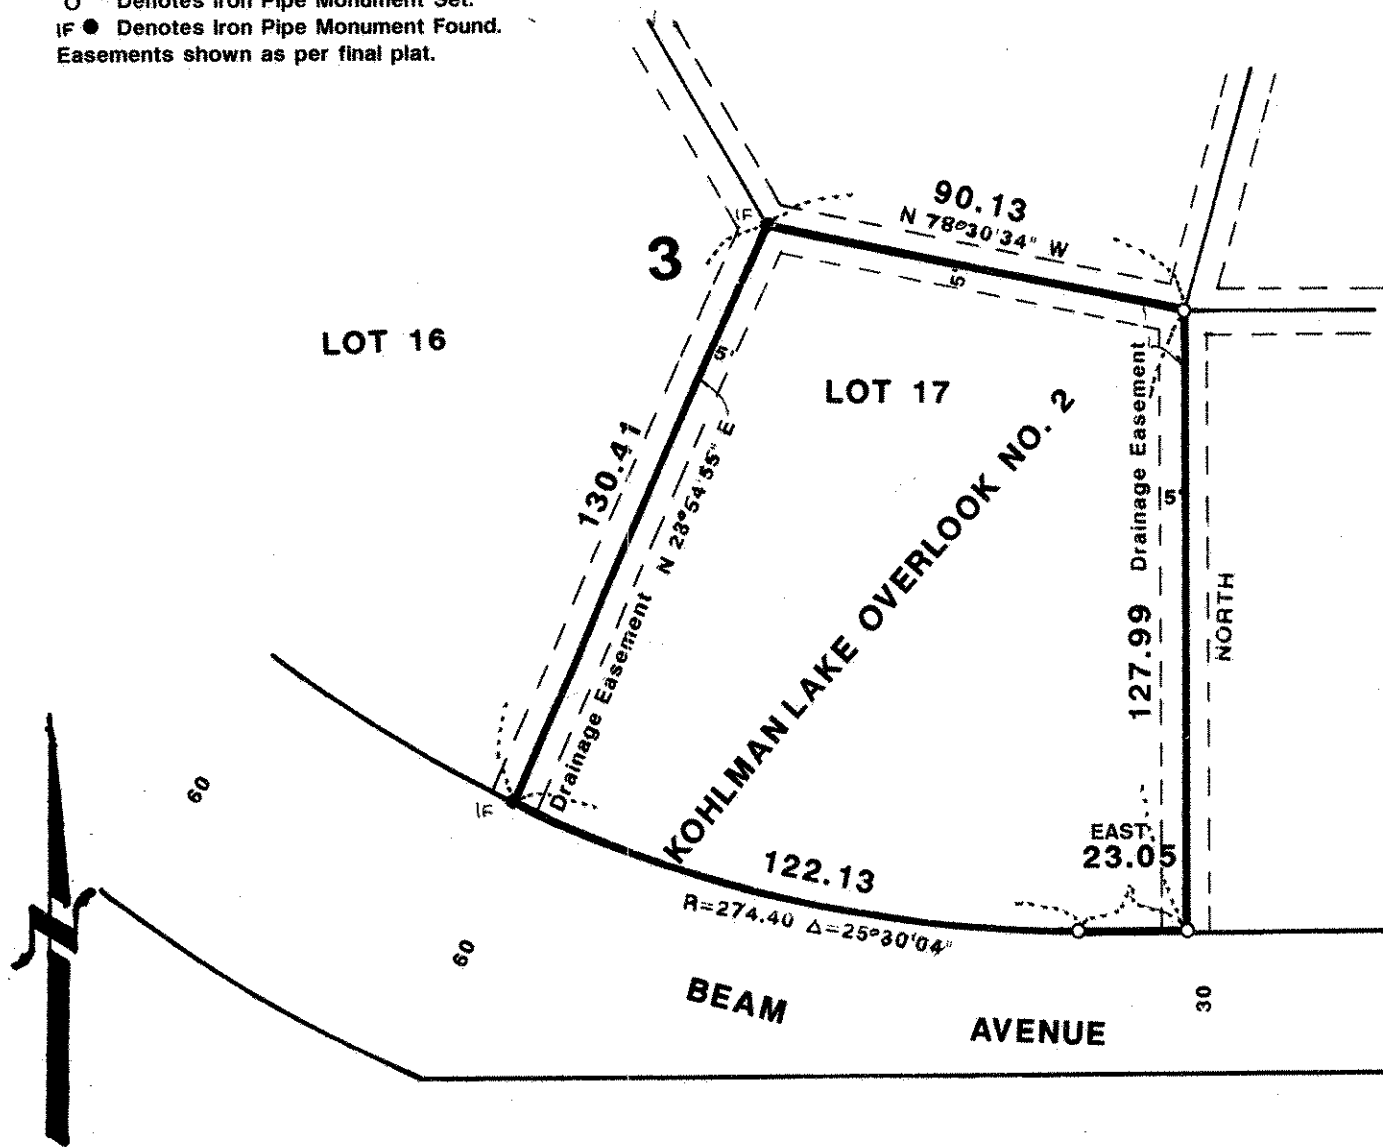

SCALE: 1"=40'

I hereby certify that this survey, plan plat, preliminary plat or report was prepared by me or under my direct supervision and that I am a duly Registered Land Surveyor under the laws of the State of Minnesota.

*Donald W. Schmidt*  
Donald W. Schmidt

10459  
Reg. No.

5/21/93  
Date

931296  
Job No.

Book No.