2 2922

FROM THE OFFICE OF

CHARLES O. GEORGI COMPANY

2215 West County Road B — Saint Paul 8, Minnesota

REGISTERED CIVIL ENGINEER AND LAND SURVEYOR

Certificate of Survey

I Hereby Certify that this plat shows a building location survey made by me on the property described on this plat, and that all locations, have been correctly shown.

A. Shuster.

Date August 1958

Scale 1" = 100'

By Charles O. Georgi
REGISTERED LAND SURVEYOR

Description:
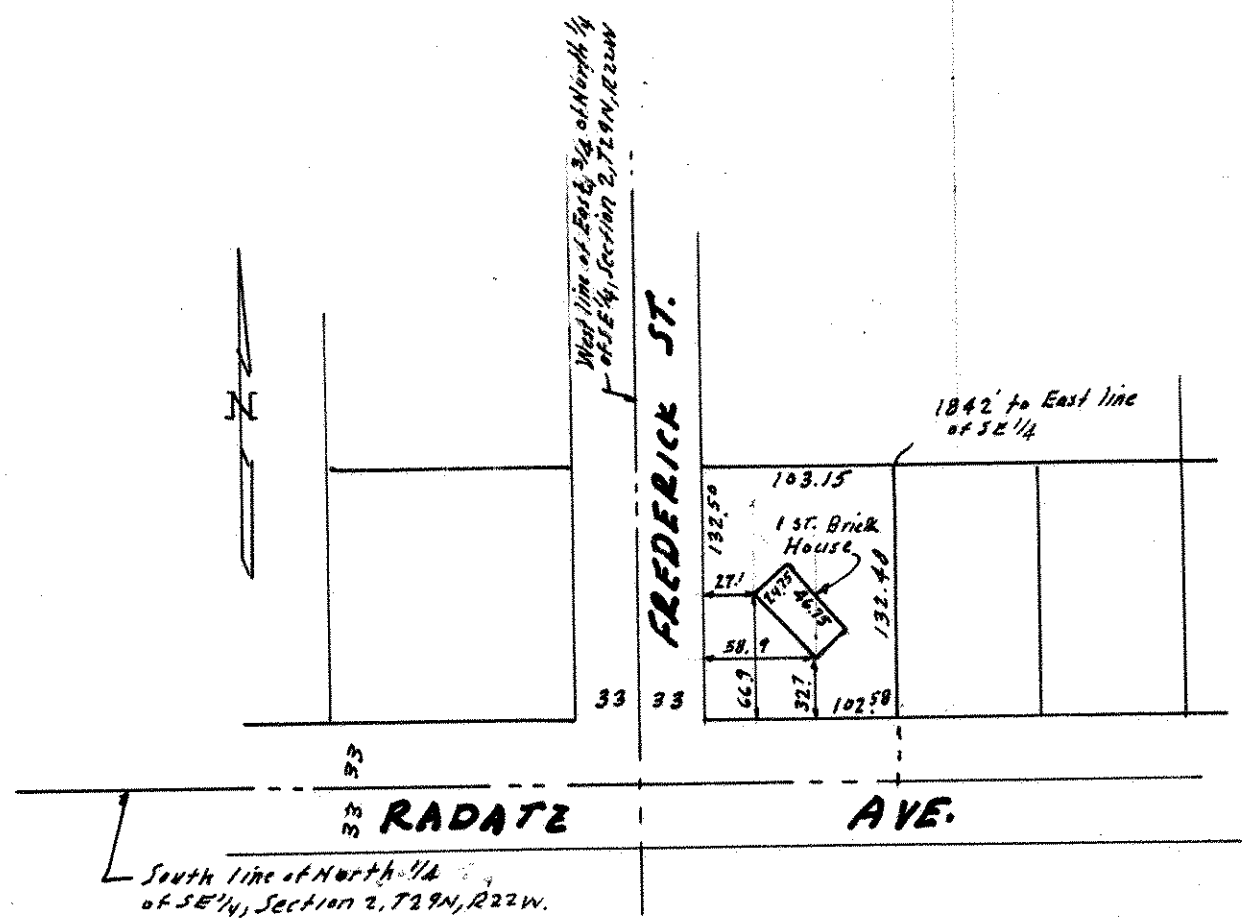
Subject to Frederick St. (formerly Van Dyke St.) all the East 3/4 of the North 1/4 of the SE 1/4, Section 2, T29N, R22W, lying North of Radatz Ave except the North 492 feet and except the East 1842 feet, according to Government Survey thereof.