

Certificate of Survey


From the office of
GEORGI SCHMIDT & ASSOC. INC.
3092 No. Lexington Ave., Roseville, Mn. 55113
LAND SURVEYING
483-4408

I Hereby Certify that this plat shows a survey made by me of the property described on this plat, and that the corners are correctly placed as shown, that this survey, plan or report was prepared by me, or under my direct supervision; and that I am a duly registered Land Surveyor under the Laws of the State of Minnesota.

Job Number: 3387
Surveyed For Schneider
Date October 22, 1987
Scale 1"=40'

By _____
REGISTERED LAND SURVEYOR
Mn. Registration No. 10459

Lot 5,
Block 2,
Spirit Hills,
Ramsey County, Minnesota.
Subject to easements of record.

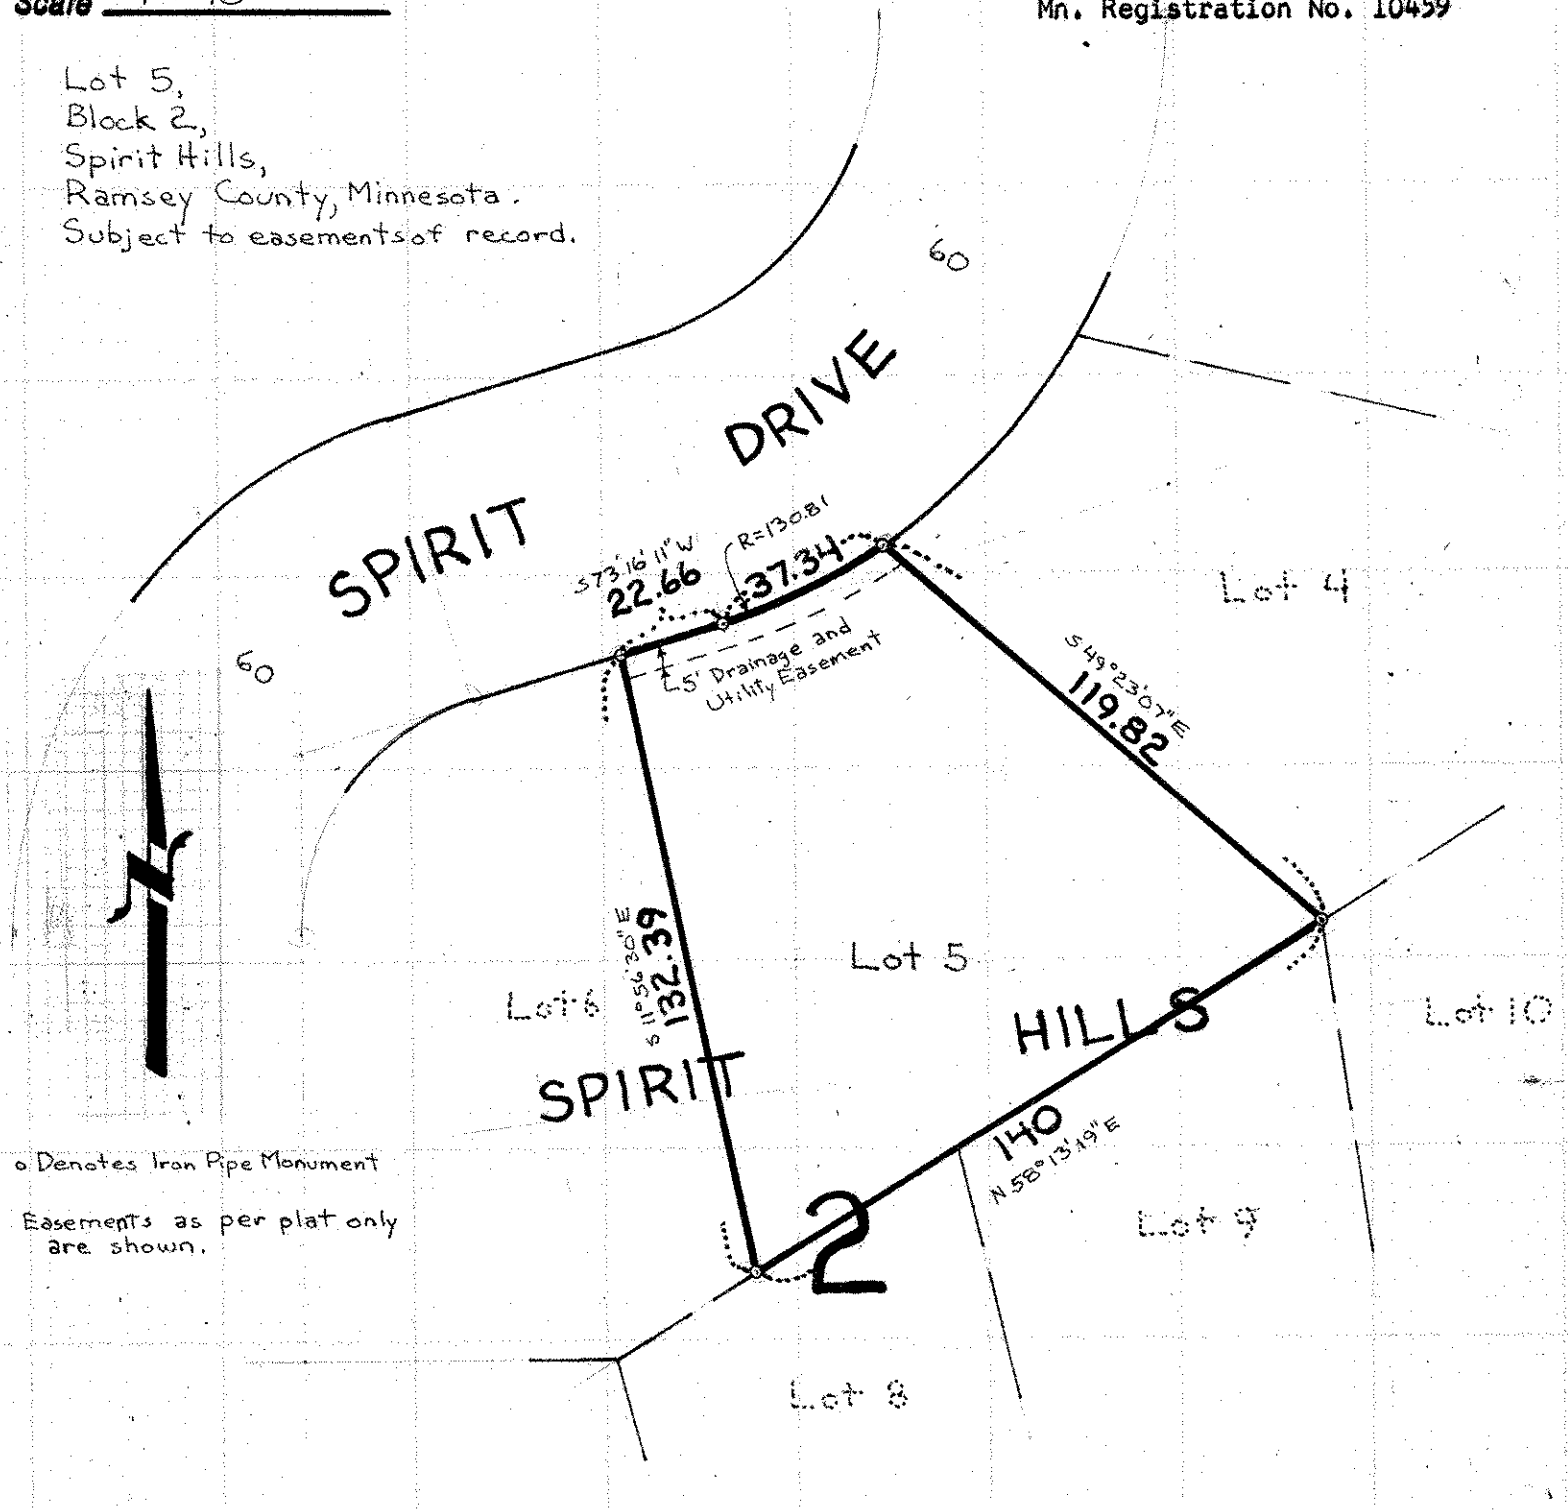

o Denotes Iron Pipe Monument
Easements as per plat only
are shown.