FROM THE OFFICE OF

Gertificate of Survey

CHARLES O. GEORGI COMPANY

2215 West County Road B

Saint Paul, Minnesota 55113

REGISTERED CIVIL ENGINEER AND LAND SURVEYOR

I Hereby Certify that this plat shows a survey made by me of the property described on this plat, and that the corners are correctly placed as shown, and that all locations have been correctly shown.

Surveyed For Atle Udstuen


Date April 1966

By Registered LAND SURVEYOR

Description:

Lot 18
Auditor Subdivision No 20
Ramsey County, Minn.

Auditoris

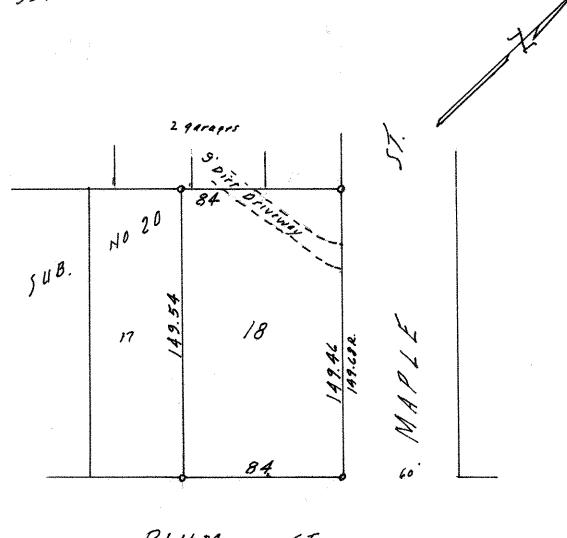

PLUM ST.

· Denotes Iron Monument.
R. Denotes Record distance on plot.