NORTHEASTERLY 1/2
LOT 2 BLOCK 3
BUTTMAN'S ADD.

JOHN B. IRVINE SURVEYOR
416 GLOBE BLD'G.
ST PAUL MINN.
SEPT 14-07
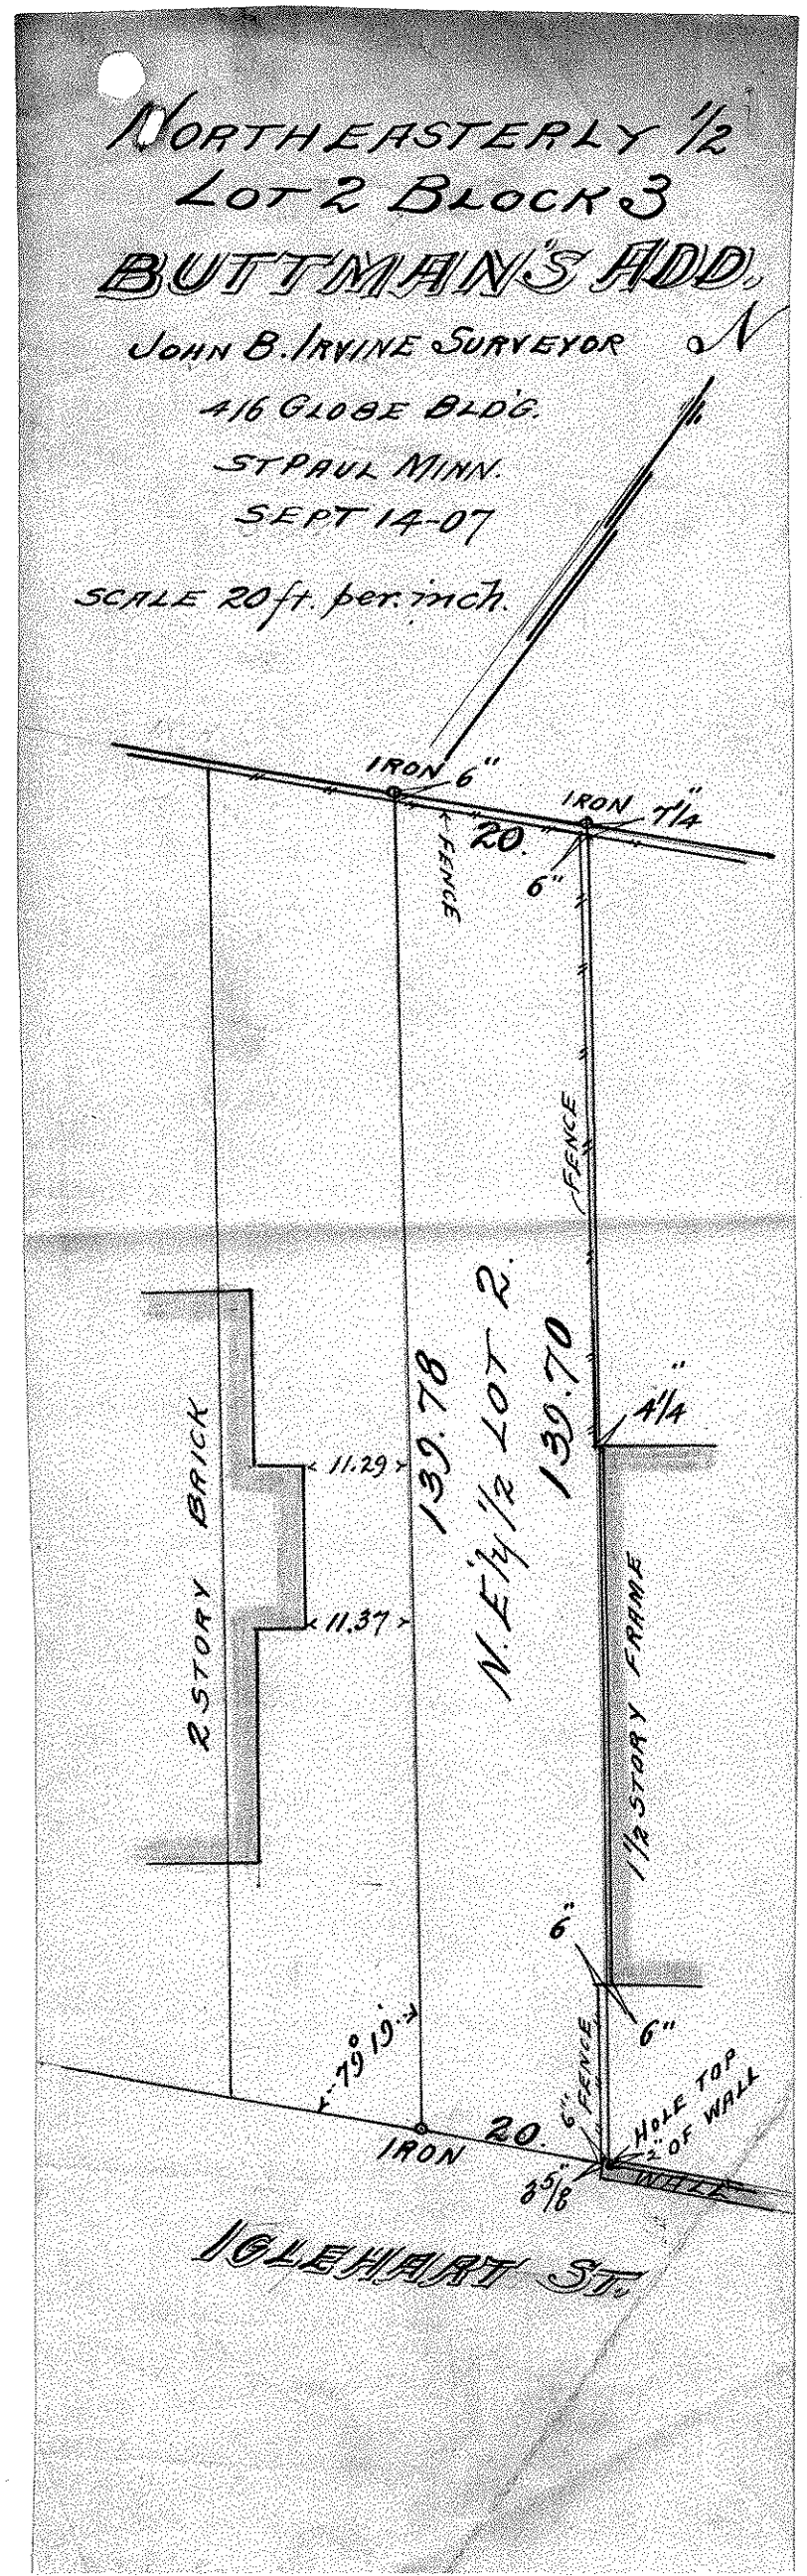
SCALE 20 ft. per. inch.