LOT 4 & EAST 11FT LOT 3 BLK 2.

BUTTMAN'S ADD.

JOHN B. IRVINE SURVEYOR.
408 GLOBE BLD'G.
ST. PAUL MINN.
APRIL 24-1911.
SCALE 20 ft per inch.

N
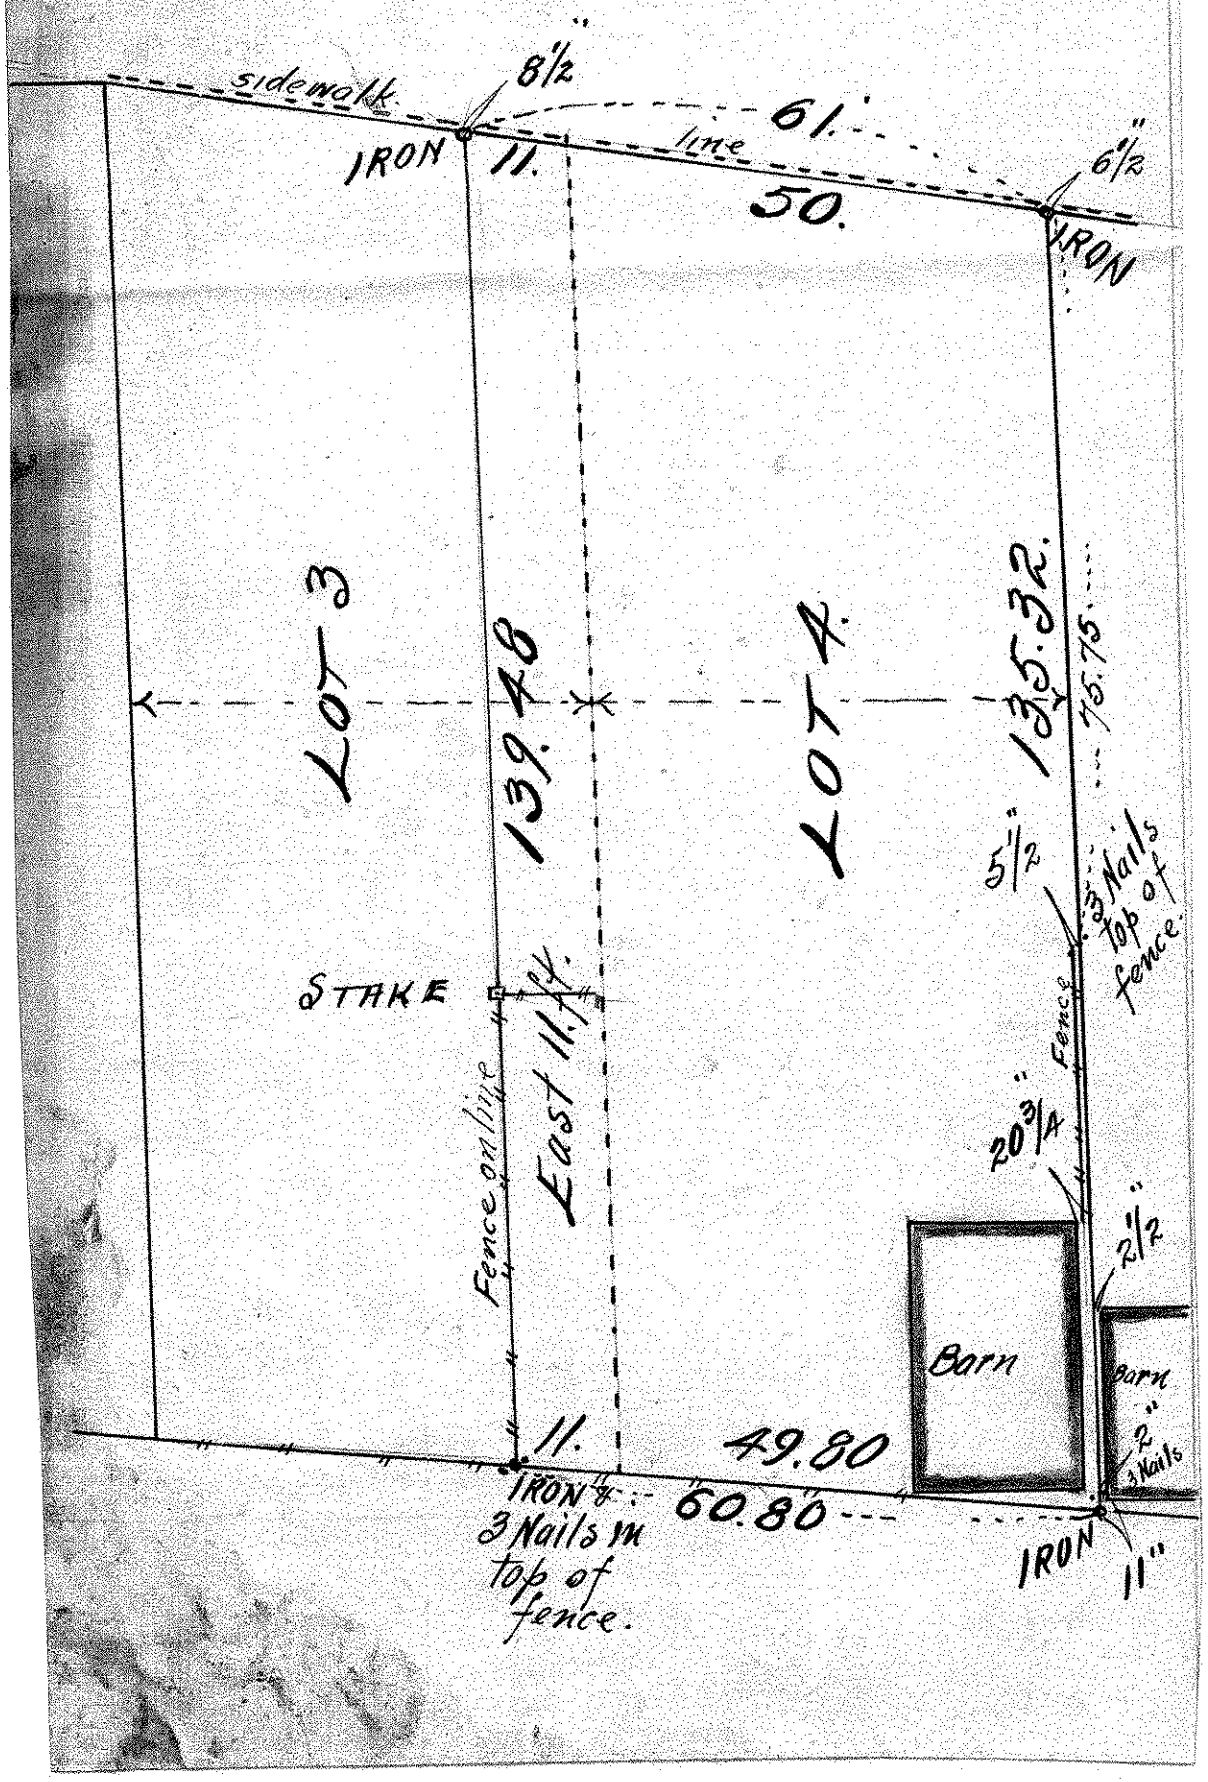
IGLEHART AVE.