


LOT 26 BLOCK 3 BORUP & PAYNE'S  
ADDITION

Scale 10 Feet pr. inch.

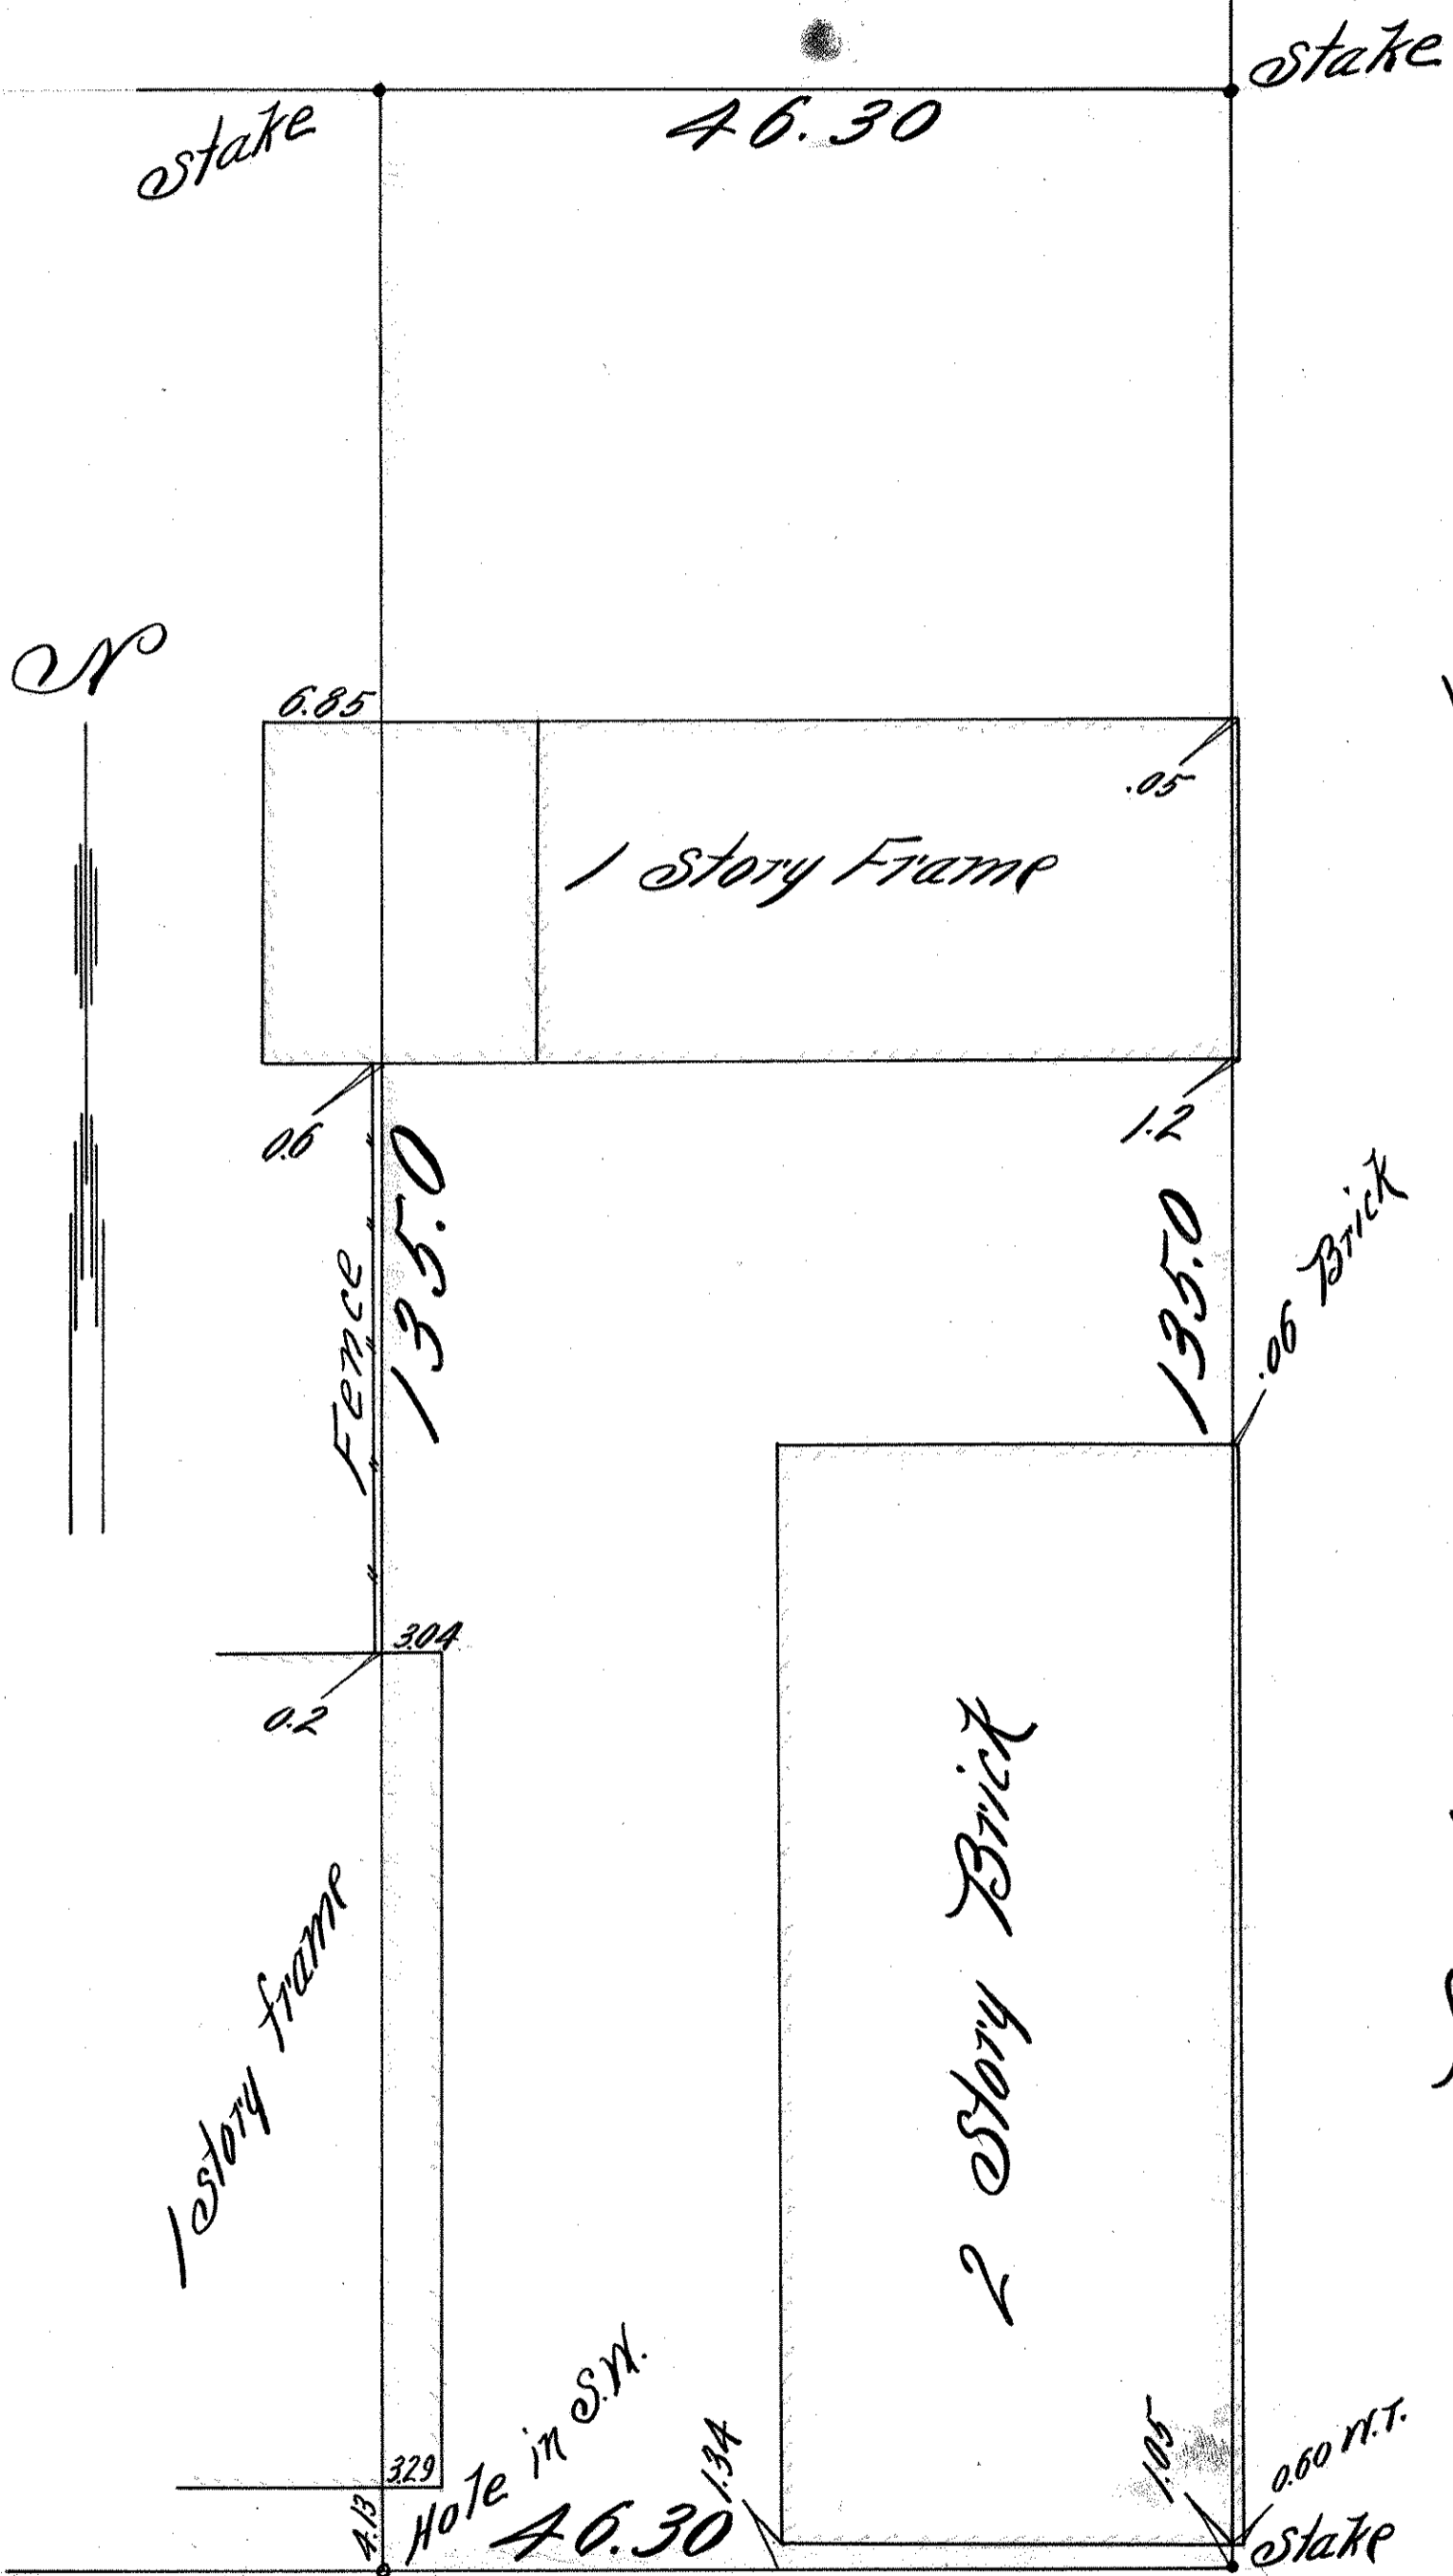

MINNEHAHA ST.

PAYNE

PAYNE

OS. Paul Minn. Aug. 29<sup>th</sup> '03  
 I hereby certify that this diagram correctly  
 represents "Lot 26 Block 3 BORUP & PAYNE'S  
 ADD." as surveyed by me this day.  
 John D. Sprone  
 County Surveyor  
 Room 16 Court House