


NE 1/4 32-29-22

JOHN B. IRVINE,
SURVEYOR
ROOM 16 COURT HOUSE.

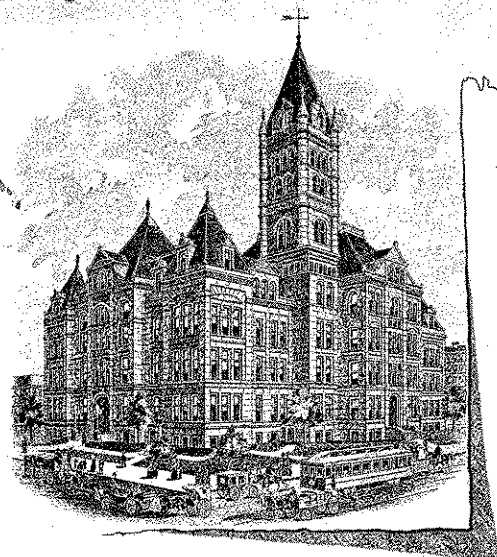

St. Paul, Minn. _____ 190

Bratz Place, Sub R 10 S D.
Richard Bratz
639 Arcade St.
April 11 - 1903
B. 54 P. 14 9/15

72927
72917
185854
72927
400000
864685
353650
791708
619476
583410
366000
54.85

