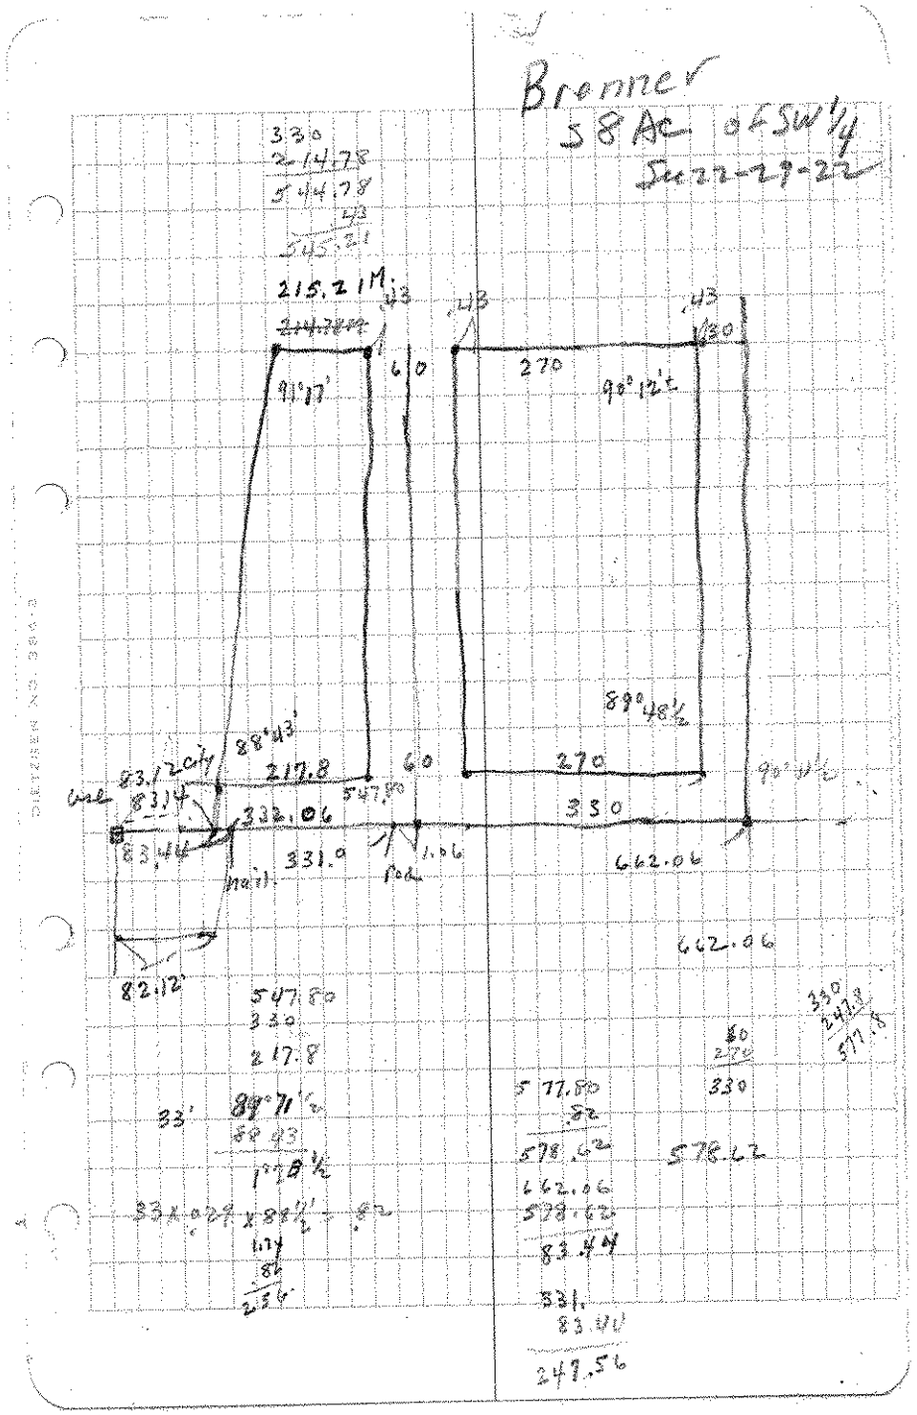
Brenner
5.8 Ac. of SW¼
Sec 22-29-22
215.21M
91°17'
270
90°12½'
89°48½'
88°43'
217.8
547.80
330.06
331.9
662.06
330
82.12'
83.12 calc
83.44
83.14
89°71½
1°18½
.82
578.62
247.56

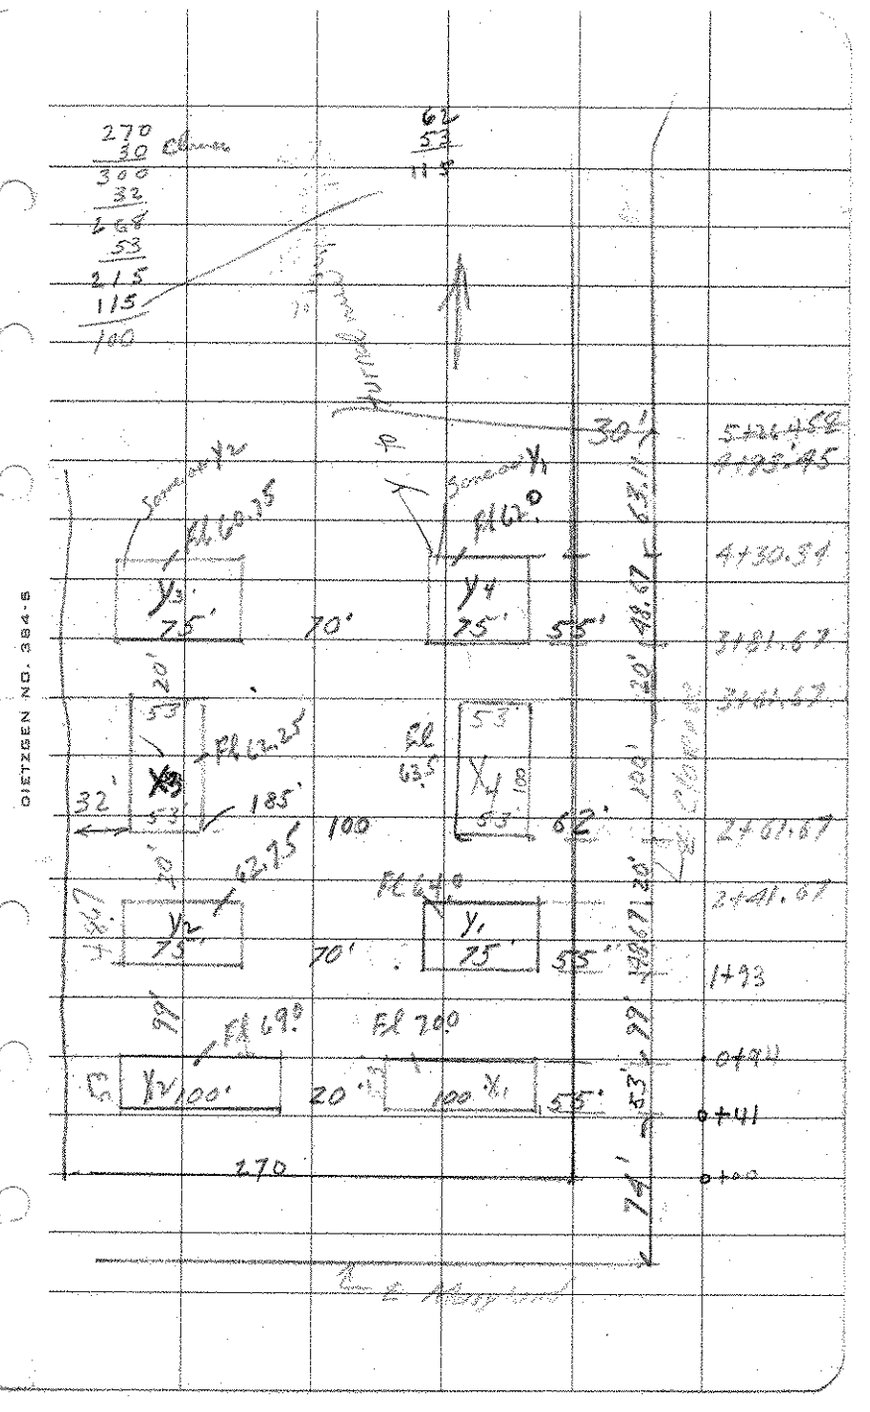
270
30
300
32
268
53
215
115
100
Semi-arc
Semi-arc
Fl 70.0
Fl 69.0
Fl 70.0
70'
70'
100'
100'
270
30'
5+26.45
4+85.45
4+30.34
3+81.67
3+41.67
2+01.67
1+41.67
1+93
0+41
0+00