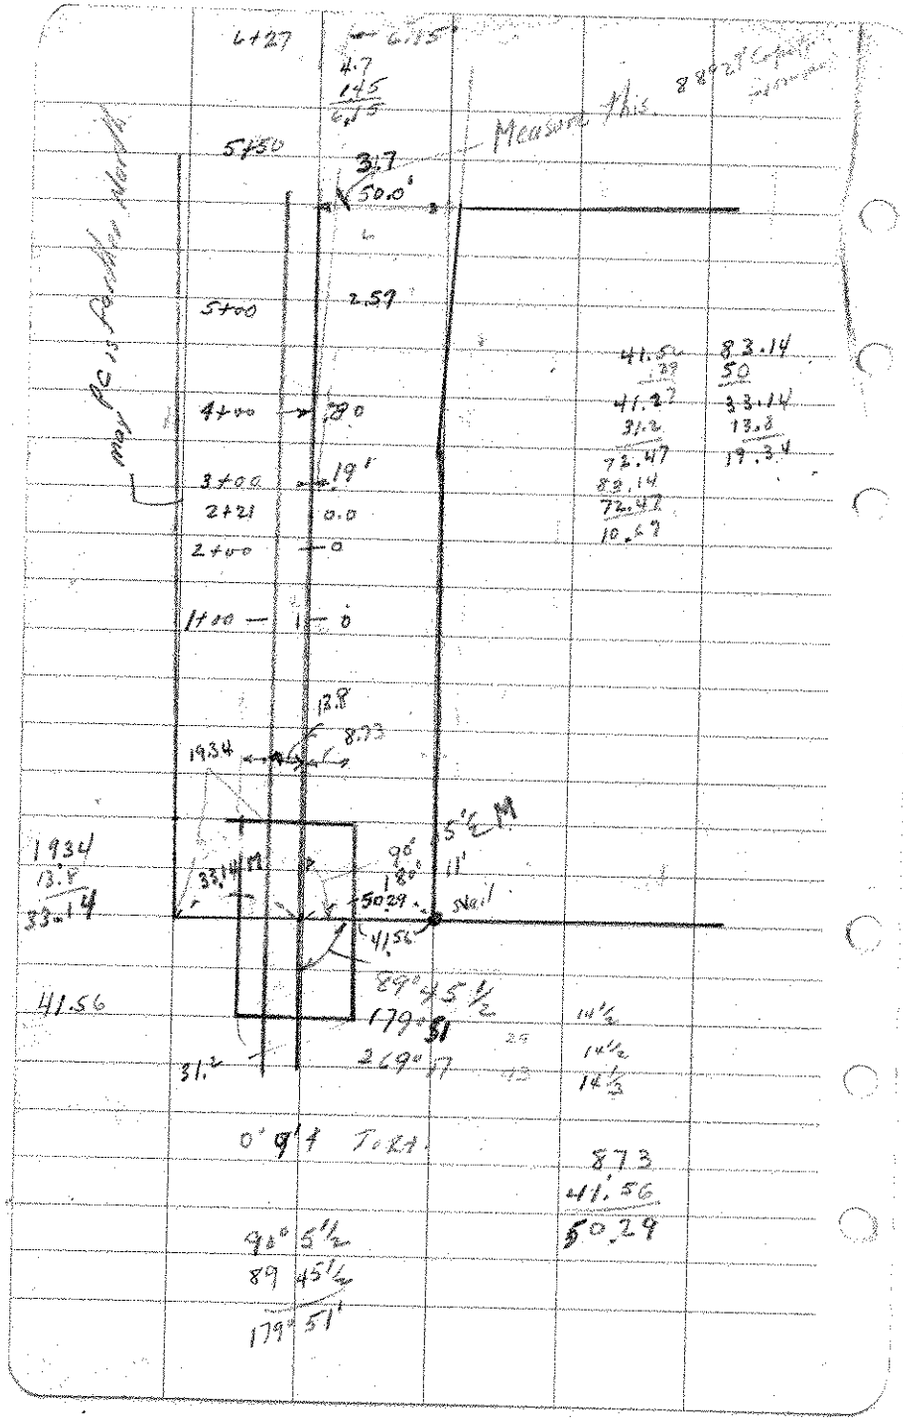
Measured N.E.
50.0'
5+50
5+00
4+00
3+00
2+21
2+00
1+00
1934
33.14
41.56
50.29
Nail
5'
11'
90°
89°
179°
31.2
0°9'
Total
90° 5½
89 45½
179° 51'