


LOTS 5 & 6 BLOCK 12  
BREWSTER'S ADD.

Scale 20 feet pr. inch  
AVE.

COMO

SEPT. 04  
CAPITOL BOULEVARD.

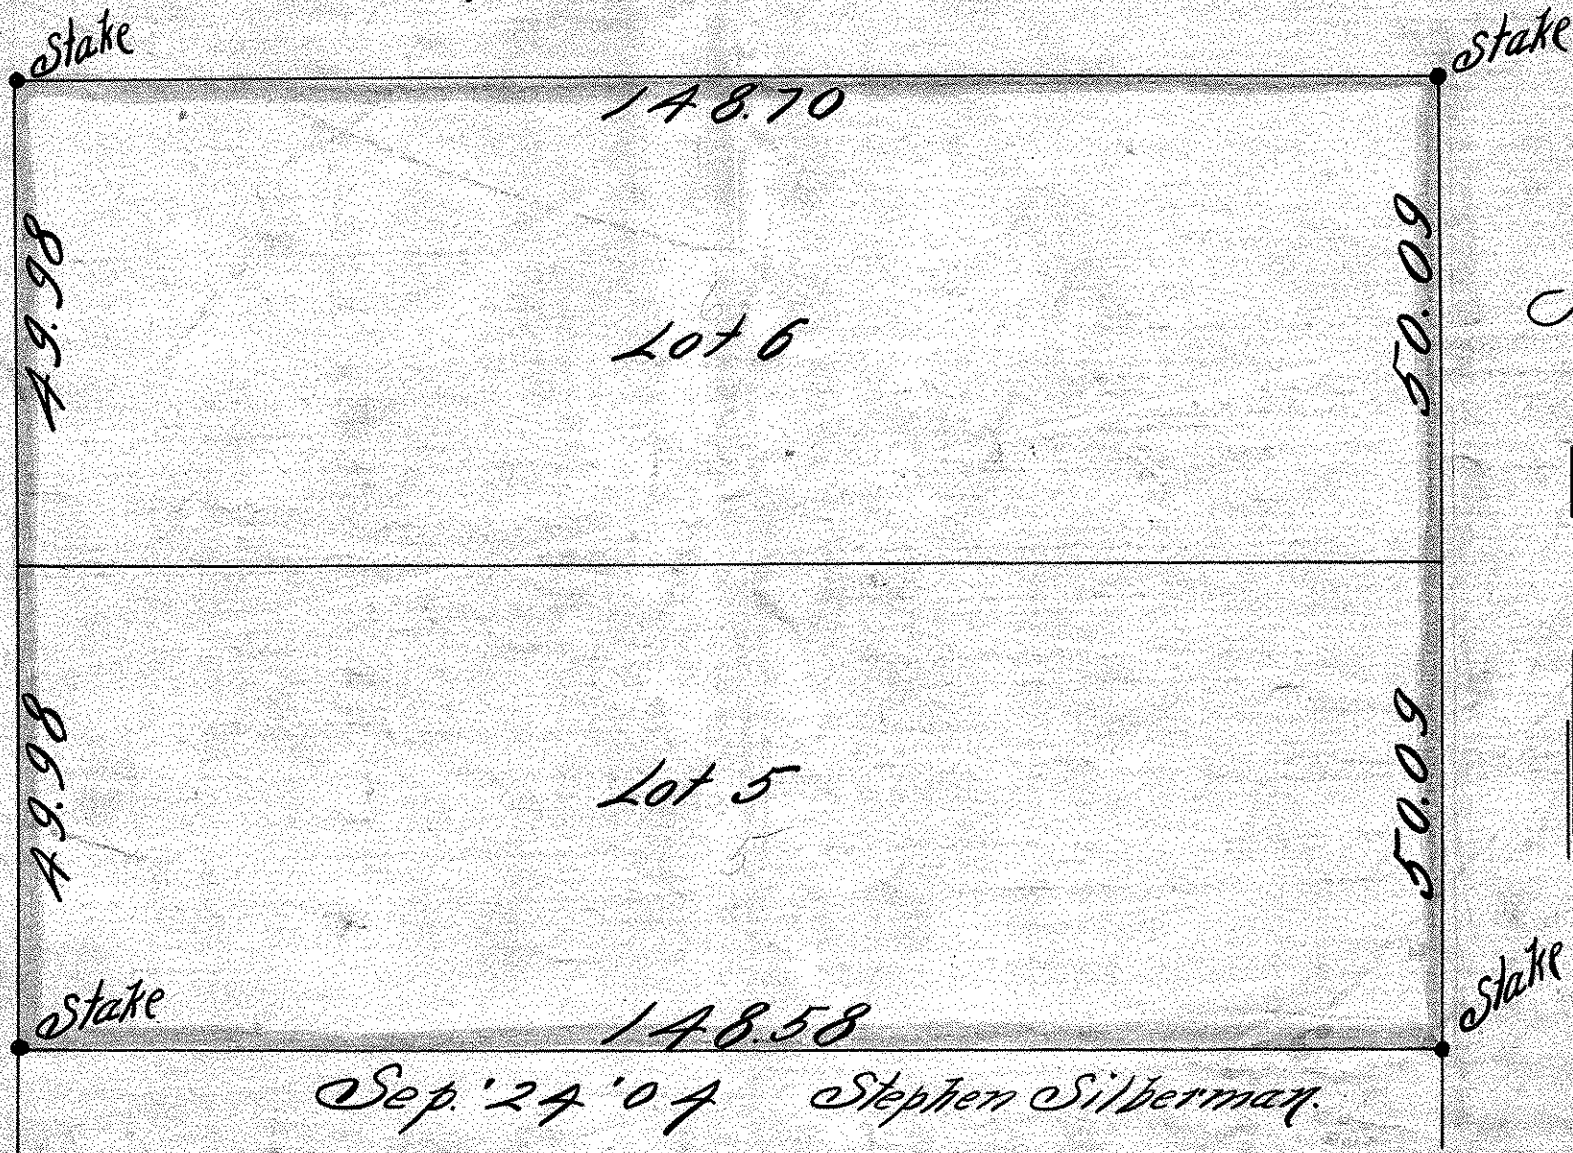

Sep. '24 '04 Stephen Silberman.