


ST. PETER ST.

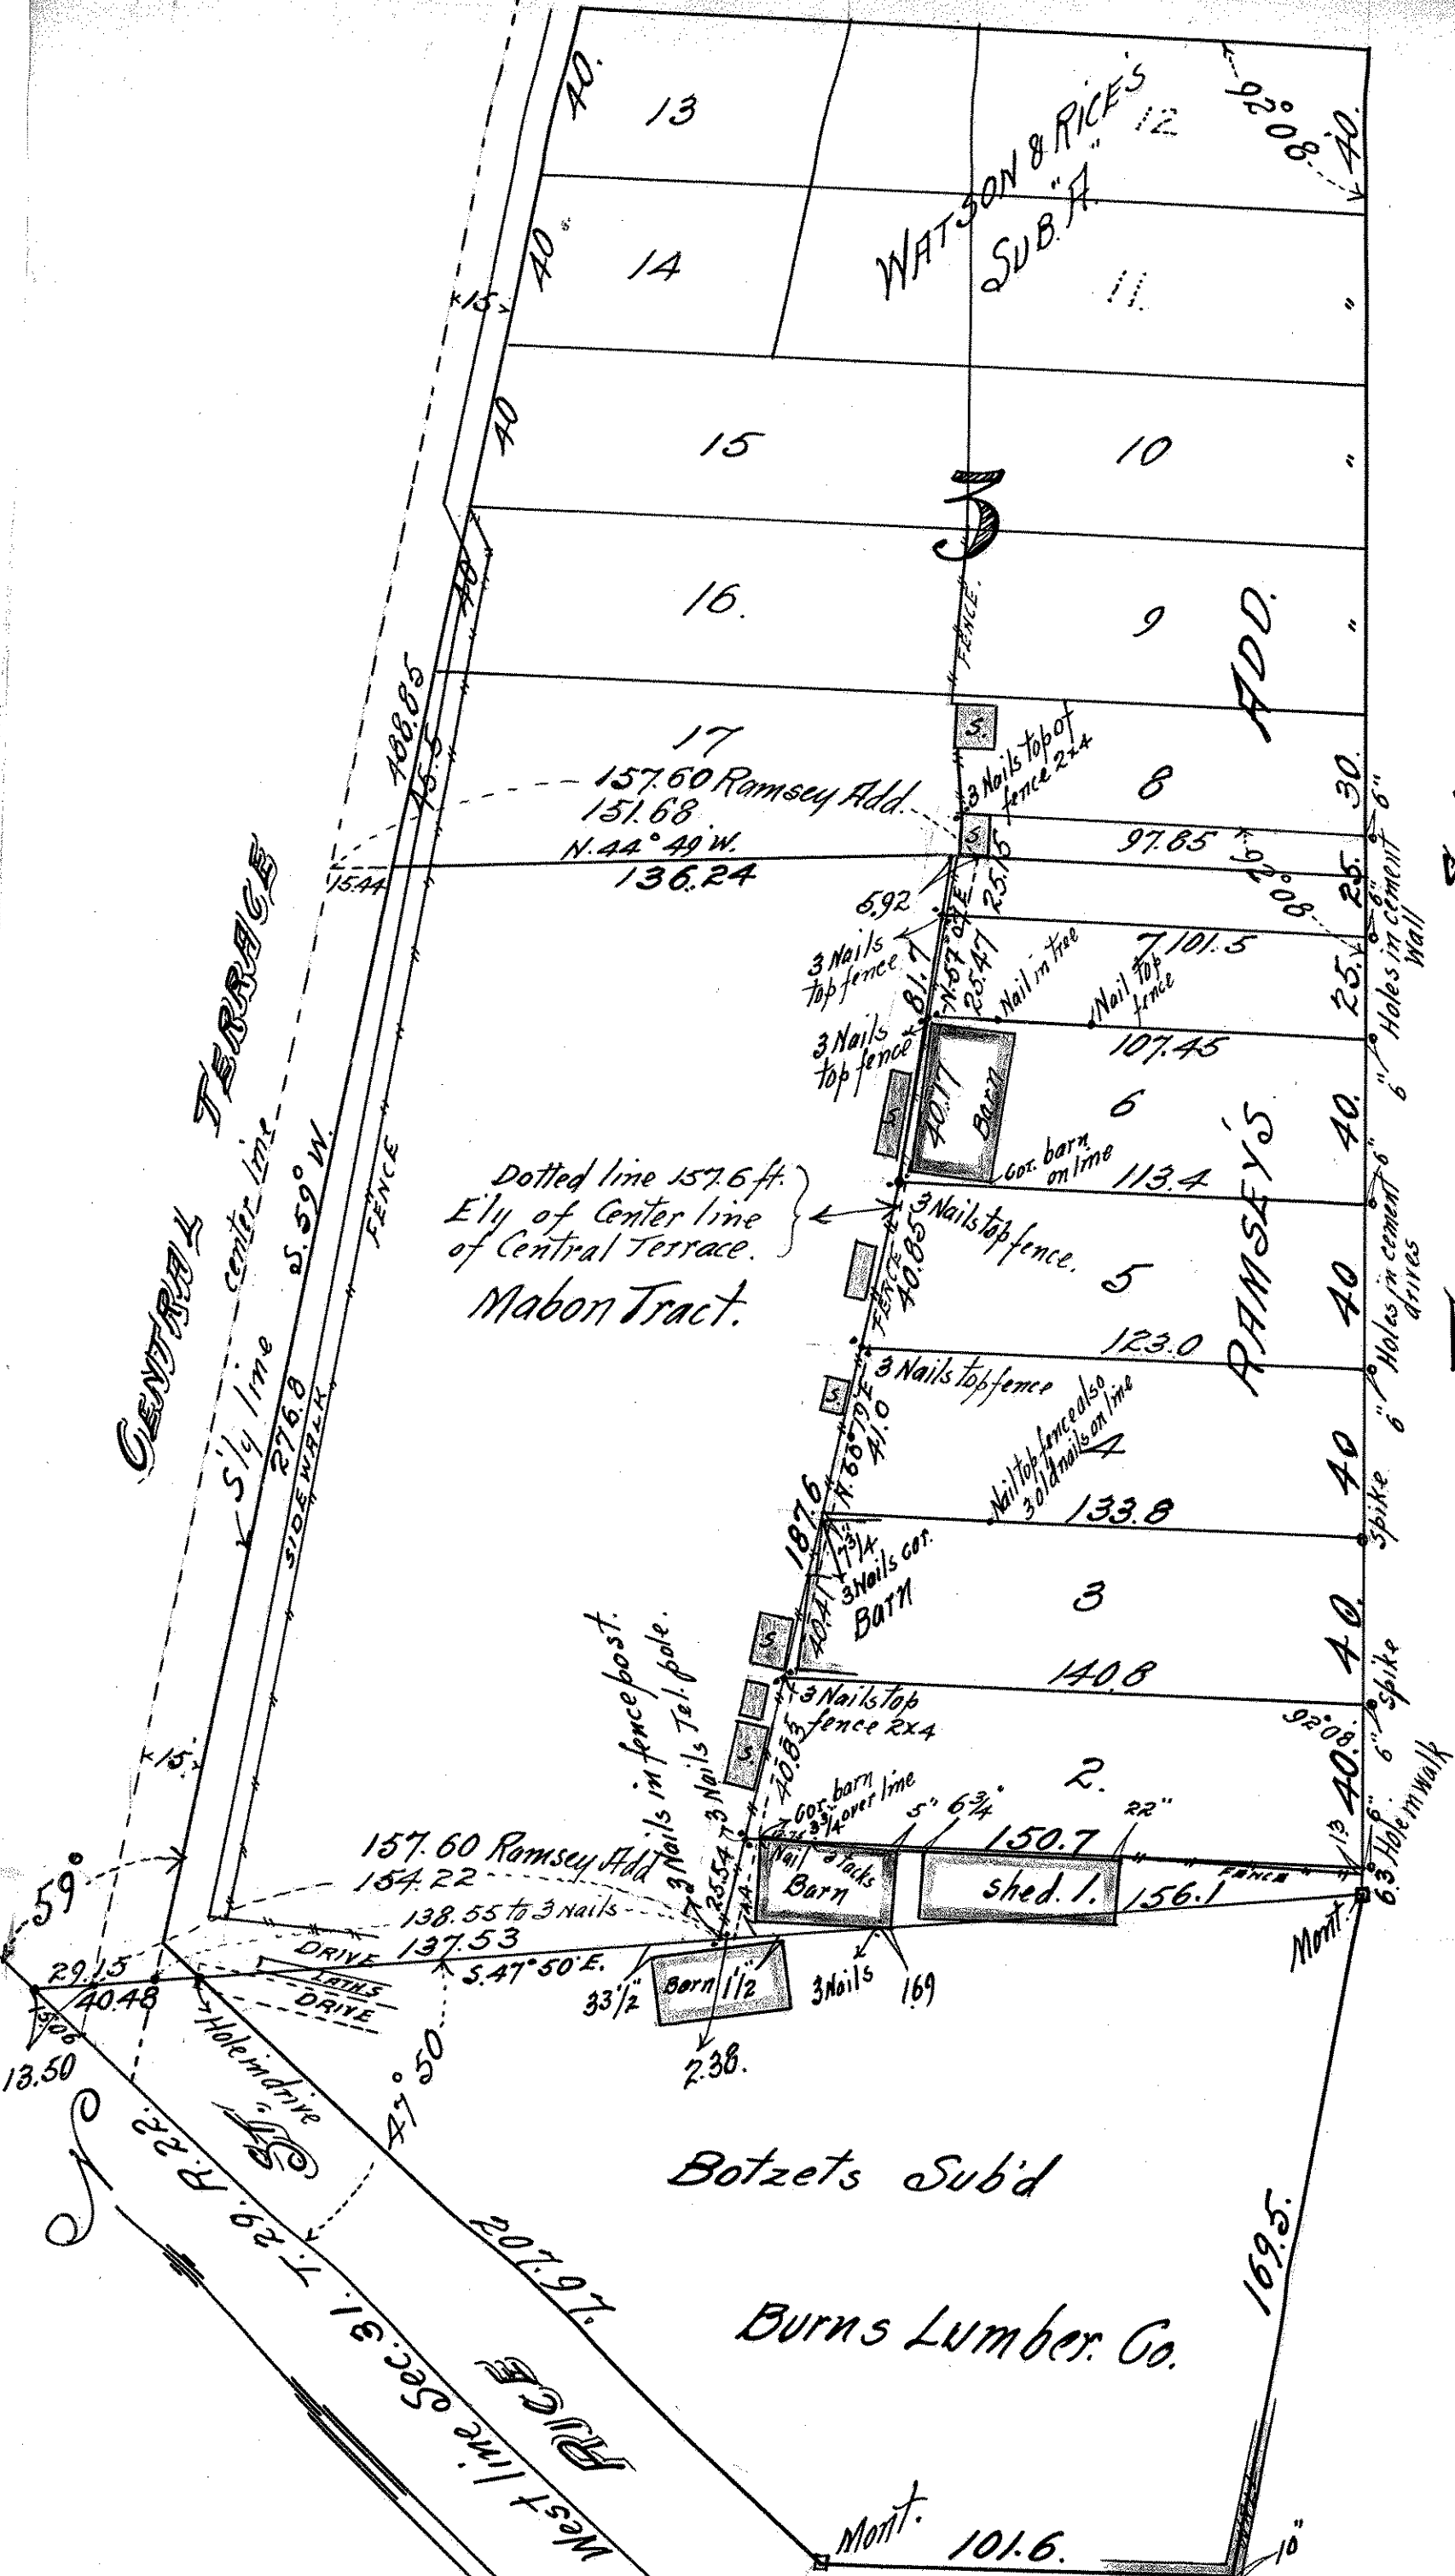

TILTON ST.

scale 40 ft. per inch.

JOHN B. IRVINE, SURVEYOR.  
 408 GLOBE BLDG.  
 ST. PAUL MINN.  
 FEB. 13-1913.

"NOTE"  
 Lengths of lots 1 to 7 = Tilton to Nails.  
 Rear of lots 1 to 7 = between Nails  
 Average Rear Width 40.81