


ST. PETER ST

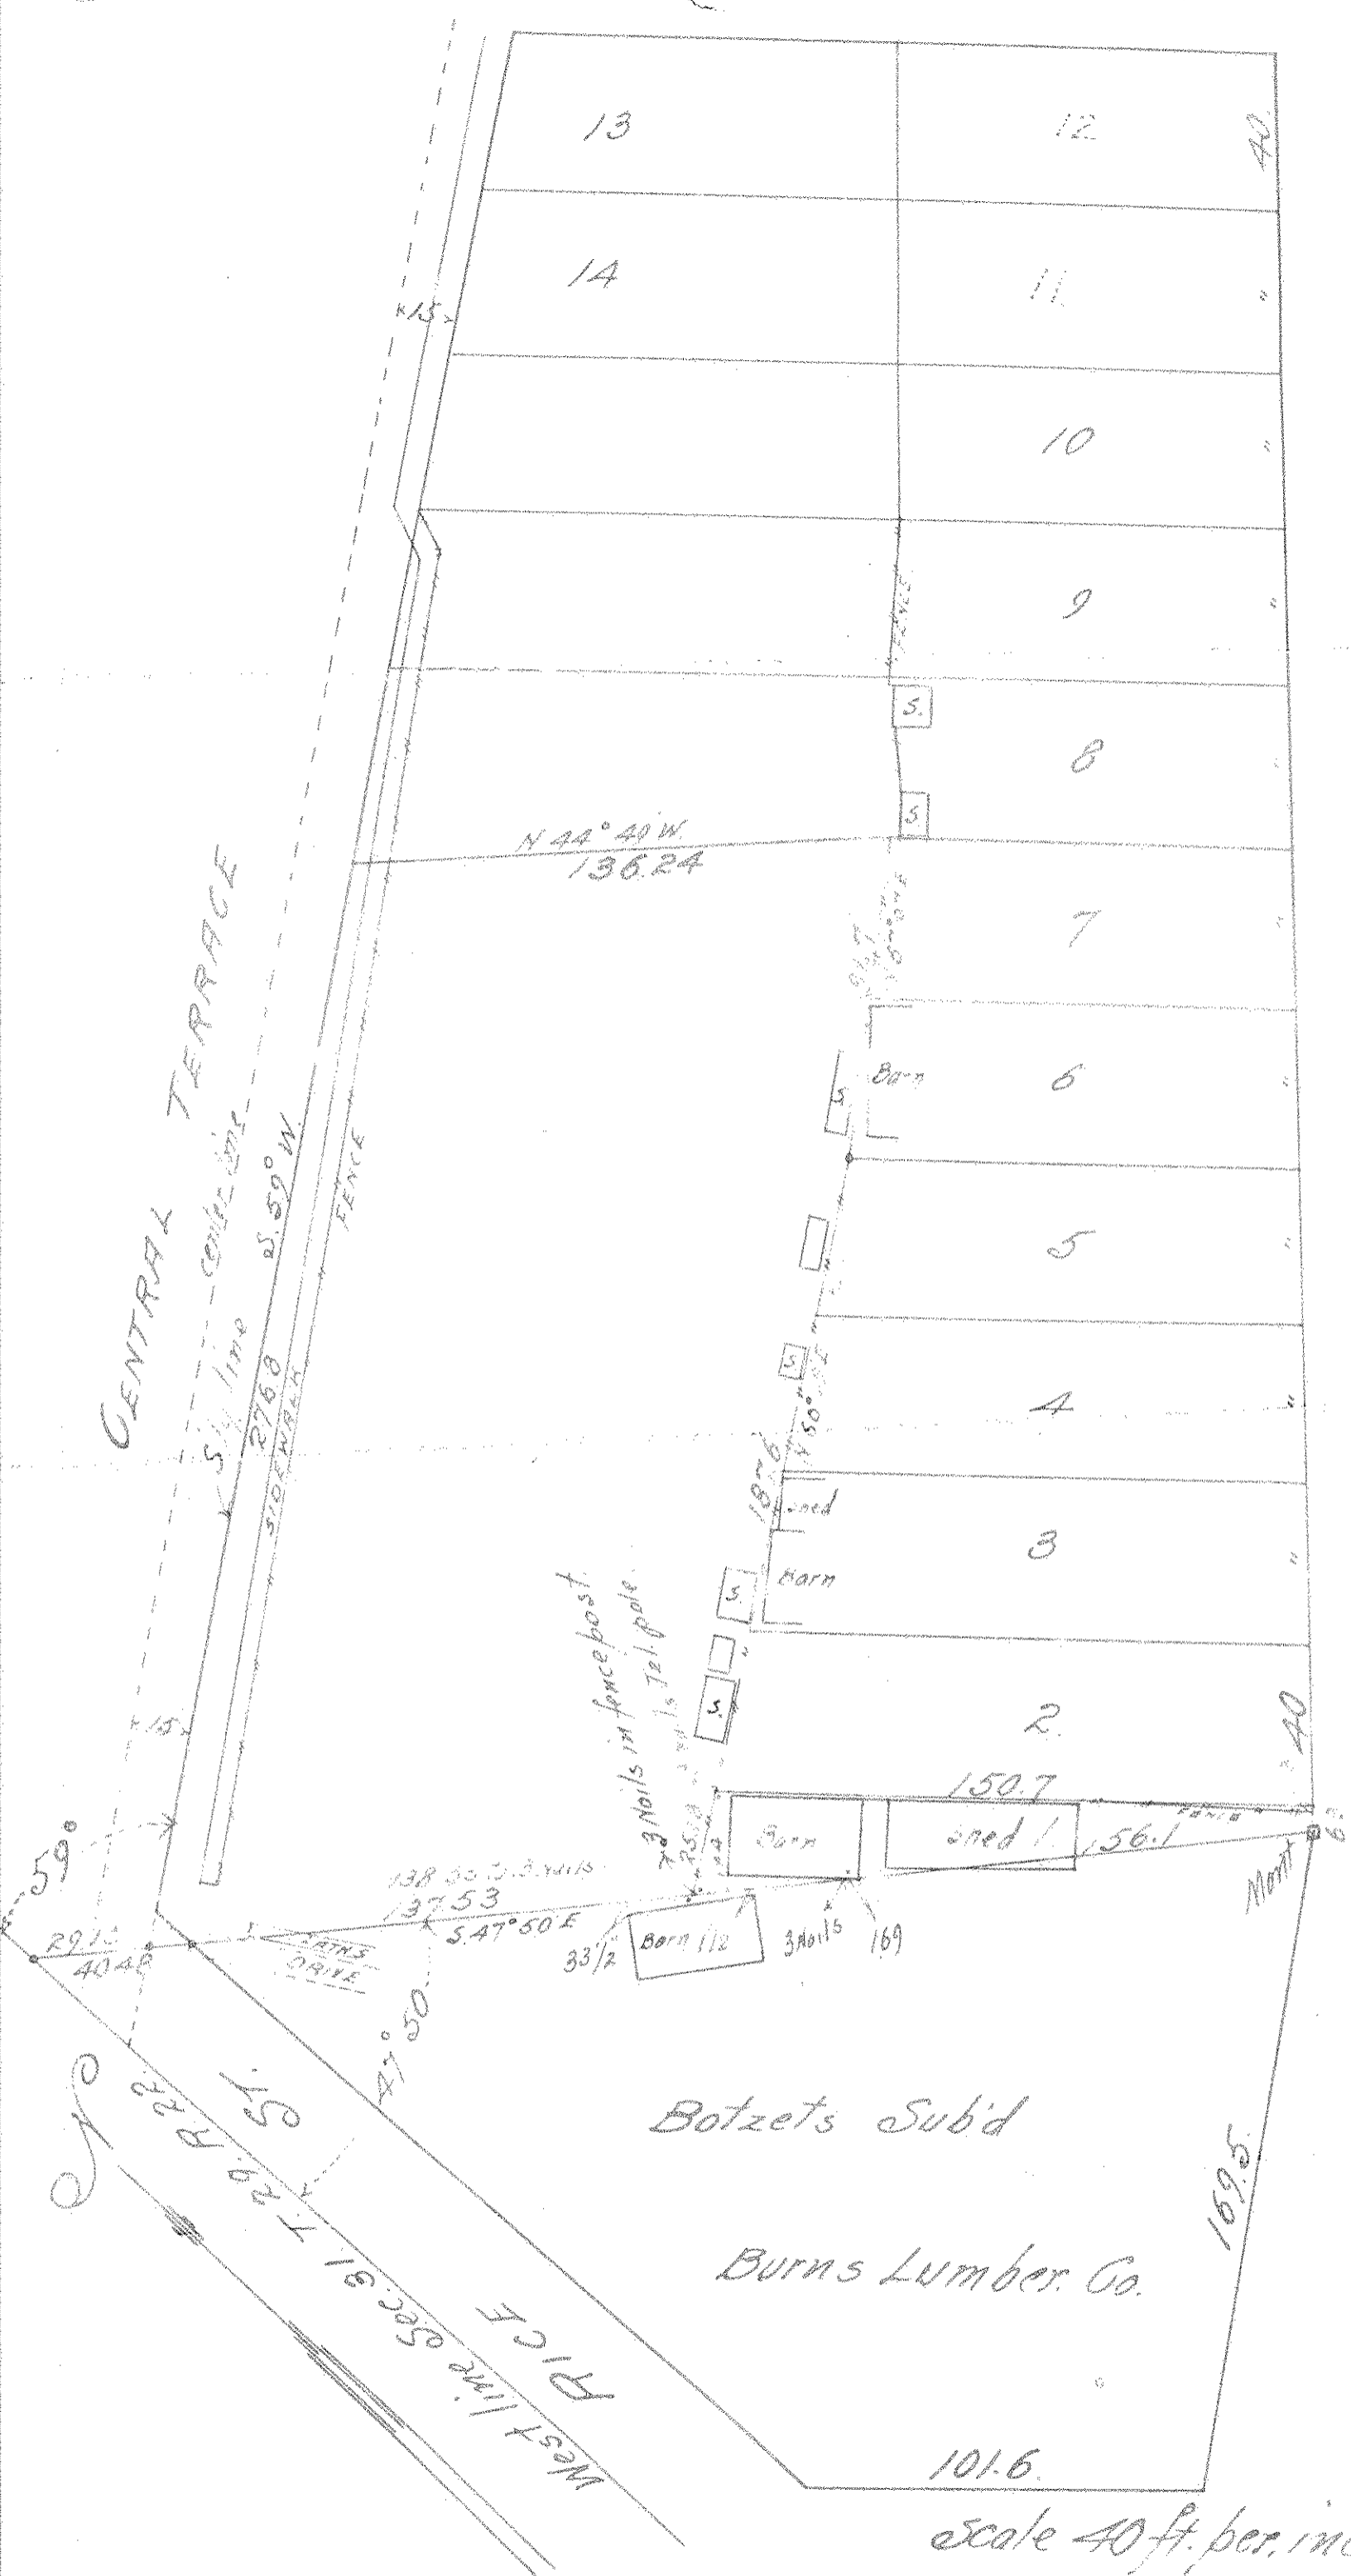

TILTON ST.

Botzets Sub'd
Burns Lumber Co.

scale 40 ft. per inch.

JOHN B. IRVINE SURVEYOR.
408 GLOBE BLDG.
ST. PAUL MINN.
FEB. 13-1913.